

CARD MUST BE TYPED

State of Kansas

CARD MUST BE SIGNED

NOTICE OF INTENTION TO DRILL

(see rules on reverse side)

Expected Spud Date..... 8 13 1988
month day year

API Number 15- 207-25,564-00-00 X East

OPERATOR: License # 5115

NE. NE. SW. Sec. 2..... Twp. 26. S, Rg. 14..... West
2465

Name REESE EXPLORATION, INC.

..... 2795 Ft. from South Line of Section
..... Ft. from East Line of Section

Address 6220 Arlington

City/State/Zip Raytown, Missouri... 64113...

Contact Person..... Patty Eichman

Phone..... (816) 356-1970

(Note: Locate well on Section Plat on reverse side)
Nearest lease or unit boundary line 175..... feet

CONTRACTOR: License # 5661

County..... WOODSON

Name Kelly Down Drilling

Lease Name..... STATE OF KANSAS Well # .. 2-88.....

City/State..... RR #1 Neosho Falls, Ks
66758

Ground surface elevation feet MSL

Well Drilled For: Well Class: Type Equipment:

Domestic well within 330 feet: ___yes X no

X Oil ___ Storage X Infield X Mud Rotary

Municipal well within one mile: ___yes X no

___ Gas ___ Inj ___ Pool Ext. ___ Air Rotary

Depth to bottom of fresh water..... 20.....

___ OWWO ___ Expl ___ Wildcat ___ Cable

Depth to bottom of usable water 225.....

IF OWWO: old well info as follows:

Surface pipe by Alternate: 1 ___ 2 X

Operator

Surface pipe planned to be set 40.....

Well Name

Conductor pipe required None.....

Comp Date..... Old Total Depth.....

Projected Total Depth 1450..... feet

I certify that well will comply with K.S.A. 55-101, et seq., plus eventually plugging hole to KCC specifications.

Formation..... Bartlesville.....

Date 8-8-88 Signature of Operator or Agent Title..... Agent

For KCC Use:

Conductor Pipe Required feet; Minimum Surface Pipe Required 40' feet per Alt. X (2)

This Authorization Expires 8-8-89 Approved By LM 8-8-88


EFFECTIVE DATE: 8-13-88

Must be filed with the K.C.C. five (5) days prior to commencing well
This card void if drilling not started within six (6) months of date received by K.C.C.

Important procedures to follow:

1. Notify District office before setting surface casing.
2. Set surface casing by circulating cement to the top.
3. File completion forms ACO-1 with K.C.C. within 120 days of well spud date, following instructions on ACO-1, side 1, and including copies of wireline logs.
4. Notify District office 48 hours prior to old well workover or re-entry.
5. Prior to filing Intent, prepare a proposed plugging plan in case well is D & A, then obtain approval of plan when calling district office prior to setting surface pipe.
6. Submit plugging report (CP-4) to K.C.C. after plugging is completed.
7. Obtain an approved injection docket number before disposing of salt water.
8. Notify K.C.C. within 10 days when injection commences or terminates.

**A Regular Section of Land
1 Mile = 5,280 Ft.**

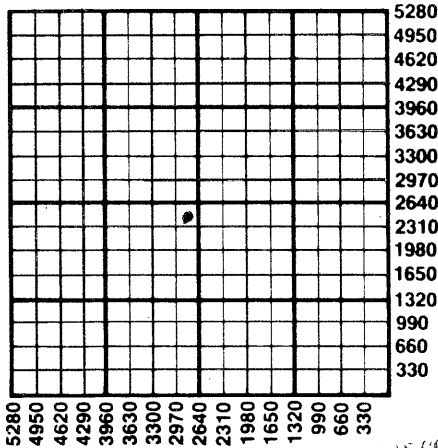

RECEIVED
STATE CORPORATION COMMISSION
STATE OF KANSAS
IRAT

AUG 8 1988

CONSERVATION DIVISION
Wichita, Kansas

and alternate 2 completion, cement in the production pipe from below any usable water to surface within 120 days of spud date.

State Corporation Commission of Kansas
Conservation Division
200 Colorado Derby Building
Wichita, Kansas 67202-1212
(316) 263-3238

8-8-88