

CARD MUST BE TYPED

State of Kansas

CARD MUST BE SIGNED

NOTICE OF INTENTION TO DRILL

(see rules on reverse side)

Expected Spud Date..... 8 14 1988
month day year

API Number 15— 207-25,567-00-00 ✓

OPERATOR: License # 5115

N¹/₂ N¹/₂ S¹/₂ Sec. 2 Twp. 26 S, Rg. 14 East

Name REESE EXPLORATION, INC.

2135 Ft. from South Line of Section

Address 6220 Arlington

2640 Ft. from East Line of Section

City/State/Zip Raytown, Missouri 64113

(Note: Locate well on Section Plat on reverse side)

Contact Person..... Patty Eichman

Nearest lease or unit boundary line 505 feet

Phone..... (816) 356-1970

County. WOODSON

CONTRACTOR: License # 5661

Lease Name... STATE OF KANSAS Well #... 5-88

Name Kelly Down Drilling

Ground surface elevation feet MSL

City/State..... Neosho Falls, Kans. 66758

Domestic well within 330 feet: _____yes no

Well Drilled For: Well Class: Type Equipment:

Municipal well within one mile: _____yes no

Oil _____ Storage Infield Mud Rotary

Depth to bottom of fresh water..... 20

_____ Gas _____ Inj _____ Pool Ext. _____ Air Rotary

Depth to bottom of usable water 225

_____ OWWO _____ Expl _____ Wildcat _____ Cable

Surface pipe by Alternate: 1 _____ 2

If OWWO: old well info as follows:

Surface pipe planned to be set 40

Operator

Conductor pipe required None

Well Name

Projected Total Depth 1450 feet

Comp Date..... Old Total Depth.....

Formation Bartlesville

I certify that well will comply with K.S.A. 55-101, et seq., plus eventually plugging hole to KCC specifications.

Date 8-9-88 Signature of Operator or Agent *Frank Ehrhart* Title..... Agent

For KCC Use:

Conductor Pipe Required feet; Minimum Surface Pipe Required 40' feet per Alt. (2)

This Authorization Expires 2-9-89 Approved By *LKM* 8-9-88


EFFECTIVE DATE: 8-14-88

Must be filed with the K.C.C. five (5) days prior to commencing well
This card void if drilling not started within six (6) months of date received by K.C.C.

Important procedures to follow:

1. Notify District office before setting surface casing.
 2. Set surface casing by circulating cement to the top.
 3. File completion forms ACO-1 with K.C.C. within 120 days of well spud date, following instructions on ACO-1, side 1, and including copies of wireline logs.
 4. Notify District office 48 hours prior to old well workover or re-entry.
 5. Prior to filing Intent, prepare a proposed plugging plan in case well is D & A, then obtain approval of plan when calling district office prior to setting surface pipe.
 6. Submit plugging report (CP-4) to K.C.C. after plugging is completed.
 7. Obtain an approved injection docket number before disposing of salt water.
 8. Notify K.C.C. within 10 days when injection commences or terminates.
9. In an alternate 2 completion, cement in the production pipe from below any usable water to surface within 120 days of spud date.

A Regular Section of Land 1 Mile = 5,280 Ft.

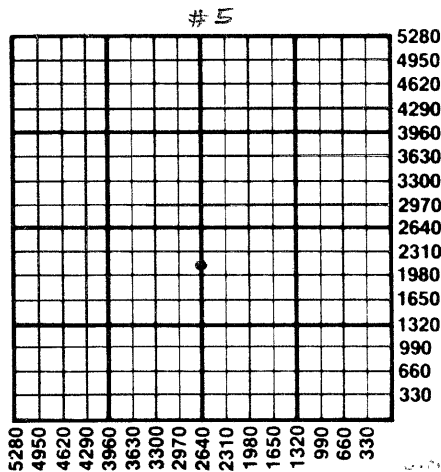

RECEIVED
STATE CORPORATION COMMISSION
AUG 9 1988

CONSERVATION DIVISION
Wichita, Kansas

State Corporation Commission of Kansas
Conservation Division
200 Colorado Derby Building
Wichita, Kansas 67202-1212
(316) 263-3238