

CARD MUST BE TYPED

State of Kansas

CARD MUST BE SIGNED

NOTICE OF INTENTION TO DRILL

Correction

(see rules on reverse side)

7-29-86

Starting Date July 31, 1986 month day year

API Number 15207-25,481-00-00

OPERATOR: License # 4884
Name Weger Petroleum Corp.
Address P.O. Box 7
City/State/Zip Chanute, Kansas 66720
Contact Person David Mc Cullough
Phone 316-431-3704

App. SE. SE. NE Sec. 11 Twp. 26S, Rg. 14.
* 2840 Ft. from South Line of Section
186 Ft. from East Line of Section

(Note: Locate well on Section Plat on reverse side)

CONTRACTOR: License #
Name Unknown
City/State

Nearest lease or unit boundary line 186 feet
County Woodson
Lease Name Kansas State Well # 1-1
Ground surface elevation n/a feet MSL

Well Drilled For: Well Class: Type Equipment:
X Oil SWD X Infield Mud Rotary
Gas Inj Pool Ext Air Rotary
OWWO Expl Wildcat Cable

Domestic well within 330 feet: yes X no
Municipal well within one mile: yes X no
Depth to bottom of fresh water 40
Depth to bottom of usable water 150
Surface pipe by Alternate: 1 2 X
Surface pipe planned to be set 40
Conductor pipe required n/a
Projected Total Depth 1500 feet
Formation Bartlesville

If OWWO: old well info as follows:

Operator
Well Name
Comp Date Old Total Depth

I certify that well will comply with K.S.A. 55-101, et seq., plus eventually plugging hole to KCC specifications.

Date 7-29-86 Signature of Operator or Agent Elaine Graham Title as agent

For KCC Use:

Conductor Pipe Required feet; Minimum Surface Pipe Required 40 feet per Alt. 40
This Authorization Expires 1-28-87 Approved By 7-28-86


Notes: 1520 FSL

Must be filed with the K.C.C. five (5) days prior to commencing well
 This card void if drilling not started within six (6) months of date received by K.C.C.

Important procedures to follow:

1. Notify District office before setting surface casing.
2. Set surface casing by circulating cement to the top.
3. File completion forms ACO-1 with K.C.C. within 90 days of well completion, following instructions on ACO-1, side 1, and including copies of wireline logs.
4. Notify District office 48 hours prior to old well workover or re-entry.
5. Prior to filing Intent, prepare a proposed plugging plan in case well is D & A, then obtain approval of plan when calling district office prior to setting surface pipe.
6. Submit plugging report (CP-4) to K.C.C. after plugging is completed.
7. Obtain an approved injection docket number before disposing of salt water.
8. Notify K.C.C. within 10 days when injection commences or terminates.
9. If an alternate 2 completion, cement in the production pipe from below any usable water to surface within 120 days of spud date.

A Regular Section of Land
1 Mile = 5,280 Ft.

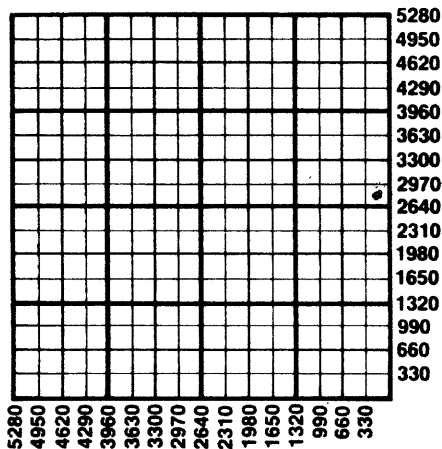

RECEIVED
 STATE CORPORATION COMMISSION

7-29-86

JUL 29 1986

CONSERVATION DIVISION
 Wichita, Kansas

State Corporation Commission of Kansas
 Conservation Division
 200 Colorado Derby Building
 Wichita, Kansas 67202
 (316) 263-3238