

CARD MUST BE TYPED

State of Kansas
NOTICE OF INTENTION TO DRILL
(see rules on reverse side)

CARD MUST BE SIGNED

Starting Date: 6 5 85
month day year

API Number 15- 107-22601-00-00

OPERATOR: License # 5756
Name Triple-I Energy Corporation
Address 6600 College Blvd., #310
City/State/Zip Overland Park, KS 66211
Contact Person Debbie Ballard
Phone (913) 345-8000

C W/2 SE SW Sec 12 Twp 22 S, Rge 21 East
(location) West

..... 660 Ft North from Southeast Corner of Section
..... 3740 Ft West from Southeast Corner of Section
(Note: Locate well on Section Plat on reverse side)

CONTRACTOR: License # 4371
Name Roberts Drilling
City/State Casper WY. 82604

Nearest lease or unit boundary line 660 feet.
County Linn
Lease Name Webber B Well# 10

Well Drilled For: Oil Gas OWWO
Well Class: Infield Pool Ext. Wildcat
Type Equipment: Mud Rotary Air Rotary Cable

Domestic well within 330 feet : yes no
Municipal well within one mile : yes no

If OWWO: old well info as follows:
Operator
Well Name
Comp Date Old Total Depth
Projected Total Depth 900 feet
Projected Formation at TD Mississippi
Expected Producing Formations

Depth to Bottom of fresh water 152 ? feet
Lowest usable water formation Chanute Shale
Depth to Bottom of usable water 150 feet
Surface pipe by Alternate : 1 2
Surface pipe to be set 20 feet
Conductor pipe if any required feet
Ground surface elevation feet MSL
This Authorization Expires 11-24-85
Approved By 5-24-85 [Signature]

I certify that we will comply with K.S.A. 55-101, et seq., plus eventually plugging hole to K.C.C. specifications.

Date 5/24/85 Signature of Operator or Agent [Signature] Title As agent

Must be filed with the K.C.C. five (5) days prior to commencing well

This card void if drilling not started within six (6) months of date received by K.C.C.


CONSERVATION DIVISION
Wichita, Kansas

MAY 24 1985

524-85

Important procedures to follow :

NOISSNUMOIO
A Regular Section of Land
1 Mile 3280 Ft.

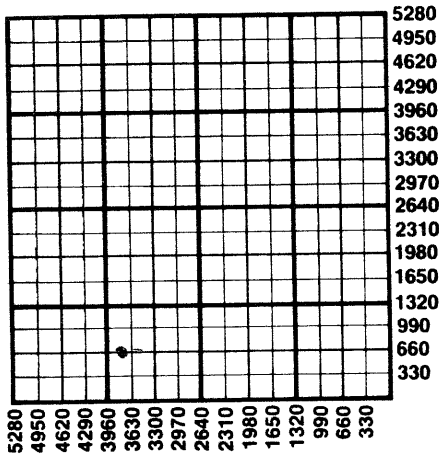

1. Notify District office before setting surface casing.
2. Set surface casing by circulating cement to the top.
3. File completion forms ACO-1 with K.C.C. within 90 days of well completion, following instructions on ACO-1, side 1, and including copies of wireline logs.
4. Notify District office 48 hours prior to old well workover or re-entry.
5. Prior to plugging, prepare a plugging plan, then obtain agreement from the appropriate district office for an approved plugging plan.
6. Submit plugging report (CP-4) to K.C.C. after plugging is completed.
7. Obtain an approved injection docket number before disposing of salt water.
8. Notify K.C.C. within 10 days when injection commences or terminates.
9. If an alternate 2 completion, cement in the production pipe from below any usable water to surface within 120 days of spud date.

State Corporation Commission of Kansas
Conservation Division
200 Colorado Derby Building
Wichita, Kansas 67202
(316) 263-3238