

CARD MUST BE TYPED

State of Kansas
NOTICE OF INTENTION TO DRILL

CARD MUST BE SIGNED

(see rules on reverse side)

Starting Date: 6 24 85
month day year

API Number 15- 107-22,62700-00

OPERATOR: License # 5756 331

44 5/12
~~app. #~~ SE. NW Sec. 12 Twp. 22 S, Rge. 21 East
(location) West

Name Triple-I Energy Corporation

Address 6600 College Blvd. #310

City/State/Zip Overland Park, KS 66211

Contact Person Debbie Ballard

Phone (913) 345-8000

..... 2860 Ft North from Southeast Corner of Section
..... 3300 Ft West from Southeast Corner of Section
(Note: Locate well on Section Plat on reverse side)

CONTRACTOR: License # 4371

Nearest lease or unit boundary line 1980 feet.

Name Roberts Drilling

County Linn

City/State Casper WY. 82604

Lease Name F.R. Farms Well# 5

Well Drilled For:

Well Class:

Type Equipment:

- Oil Swd Infield
- Gas Inj Pool Ext.
- OWWO Expl Wildcat

- Mud Rotary
- Air Rotary
- Cable

Domestic well within 330 feet: yes no

Municipal well within one mile: yes no

If OWWO: old well info as follows:

Depth to Bottom of fresh water 75 feet

Lowest usable water formation .. Dennis Limestone ..

Depth to Bottom of usable water 150 feet

Surface pipe by Alternate: 1 2

Surface pipe to be set 20 feet

Conductor pipe if any required feet

Ground surface elevation feet MSL

This Authorization Expires 12-24-85

Approved By *6-24-85* *R*

I certify that we will comply with K.S.A. 55-101, et seq., plus eventually plugging hole to K.C.C. specifications.

Date . 6/24/85 Signature of Operator or Agent

Raquel Forbes

Title

MHC/MOHE 6-24-85

As agent

Must be filed with the K.C.C. five (5) days prior to commencing well
This card void if drilling not started within six (6) months of date received by K.C.C.


RECEIVED
STATE CORPORATION COMMISSION

JUN 21 1985
A Regular Section of Land
1 Mile = 5,280 Feet
CONSERVATION DIVISION
Wichita, Kansas

6-24-85

Important procedures to follow :

1. Notify District office before setting surface casing.
2. Set surface casing by circulating cement to the top.
3. File completion forms ACO-1 with K.C.C. within 90 days of well completion, following instructions on ACO-1, side 1, and including copies of wireline logs.
4. Notify District office 48 hours prior to old well workover or re-entry.
5. Prior to plugging, prepare a plugging plan, then obtain agreement from the appropriate district office for an approved plugging plan.
6. Submit plugging report (CP-4) to K.C.C. after plugging is completed.
7. Obtain an approved injection docket number before disposing of salt water.
8. Notify K.C.C. within 10 days when injection commences or terminates.
9. If an alternate 2 completion, cement in the production pipe from below any usable water to surface within 120 days of spud date.

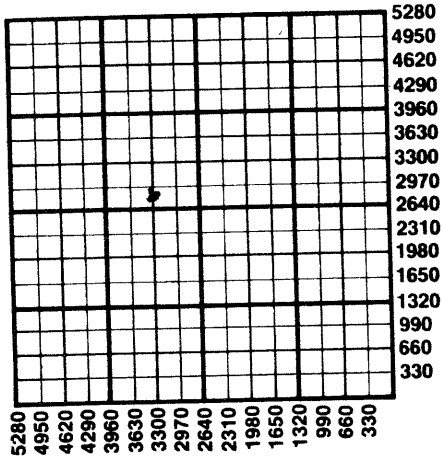

State Corporation Commission of Kansas
Conservation Division
200 Colorado Derby Building
Wichita, Kansas 67202
(316) 263-3238