

CARD MUST BE TYPED

State of Kansas NOTICE OF INTENTION TO DRILL (see rules on reverse side)

CARD MUST BE SIGNED

Starting Date: 8 3 1985
month day year

API Number 15- 107-22,681-00-00

OPERATOR: License # 6437-~~643~~.....

App. SE SW SE Sec. 1... Twp 22... S, Rge 21...
(location) ☒ East ☐ West

Name Robert Edwards (Red Bear) ~~Red Bear~~

Address 525 East 86th Street

City/State/Zip New York, New York 10028

Contact Person Robert Edwards

Phone 212 535 8377

165 Ft North from Southeast Corner of Section
1875 Ft West from Southeast Corner of Section
(Note: Locate well on Section Plat on reverse side)

CONTRACTOR: License # ~~8449~~ 8469

Name Nickell Drilling

City/State Parker, KS 66072

Nearest lease or unit boundary line 165 feet.
County Ball Linn

Lease Name Ball Linn Well# 3

Domestic well within 330 feet: ☐ yes ☒ no

Municipal well within one mile: ☐ yes ☒ no

Well Drilled For: Well Class: Type Equipment:

☒ Oil ☐ Swd ☒ Infield ☒ Mud Rotary

☐ Gas ☐ Inj ☐ Pool Ext. ☐ Air Rotary

☐ OWWO ☐ Expl ☐ Wildcat ☐ Cable

If OWWO: old well info as follows:

Operator

Well Name

Comp Date Old Total Depth

Projected Total Depth 800 feet

Projected Formation at TD

Expected Producing Formations

Depth to Bottom of fresh water none feet

Lowest usable water formation 150 feet

Depth to Bottom of usable water 150 feet

Surface pipe by Alternate: 1 ☐ 2 ☒

Surface pipe to be set 20 feet

Conductor pipe if any required feet

Ground surface elevation feet MSL

This Authorization Expires 2-2-86

Approved By 8-2-85 *RCH*

I certify that we will comply with K.S.A. 55-101, et seq., plus eventually plugging hole to K.C.C. specifications.

Date 8/2/85 Signature of Operator or Agent *Robert Edwards* Title as agent


Must be filed with the K.C.C. five (5) days prior to commencing well
This card void if drilling not started within six (6) months of date received by K.C.C.

RECEIVED
STATE CORPORATION COMMISSION

Important procedures to follow:

AUG 9 1985

A Regular Section of Land
1 Mile = 5,280 Ft.

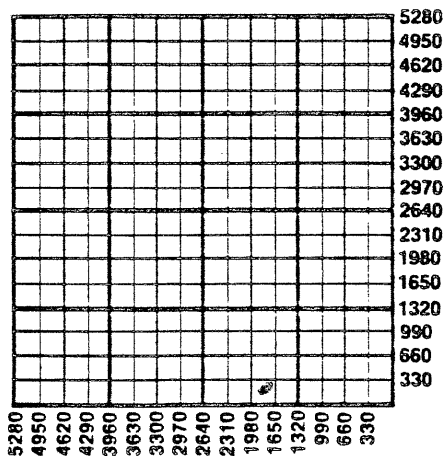

1. Notify District office before setting surface casing.
2. Set surface casing by circulating cement to the top.
3. File completion forms ACO-1 with K.C.C. within 90 days of well completion, following instructions on ACO-1, side 1, and including copies of wireline logs.
4. Notify District office 48 hours prior to old well workover or re-entry.
5. Prior to plugging, prepare a plugging plan, then obtain agreement from the appropriate district office for an approved plugging plan.
6. Submit plugging report (CP-4) to K.C.C. after plugging is completed.
7. Obtain an approved injection docket number before disposing of salt water.
8. Notify K.C.C. within 10 days when injection commences or terminates.
9. If an alternate 2 completion, cement in the production pipe from below any usable water to surface within 120 days of spud date.

CONSERVATION DIVISION

Wichita, Kansas

8-2-85

State Corporation Commission of Kansas

Conservation Division

200 Colorado Derby Building

Wichita, Kansas 67202

(316) 263-3238