

CARD MUST BE TYPED

State of Kansas

CARD MUST BE SIGNED

# NOTICE OF INTENTION TO DRILL

(see rules on reverse side)

Expected Spud Date..... 03/09/88  
month      day      year

API Number 15- 107-22969-00-00

OPERATOR: License #..... 4905  
Name..... K.C. Crude, Inc.  
Address..... 6520 West 110th #106  
City/State/Zip..... Overland Park, Kansas 66211  
Contact Person..... Larry W. Brown  
Phone..... (913) 345-8000

S 1/2 S 1/2 SE SE Sec. 1 Twp. 22 S, Rg. 21 XX East  
..... 220 ..... West  
..... 660 ..... Ft. from South Line of Section  
..... ..... Ft. from East Line of Section

(Note: Locate well on Section Plat on reverse side)

CONTRACTOR: License #.....  
Name..... Unknown  
City/State.....

Nearest lease or unit boundary line..... 220 ..... feet  
County..... Tinn

Well Drilled For:      Well Class:      Type Equipment:  
 Oil       Storage       Infield       Mud Rotary  
 Gas       Inj       Pool Ext.       Air Rotary  
 OWWO       Expl       Wildcat       Cable

Lease Name..... Ball C Well #..... C-5

Ground surface elevation..... ..... feet MSL

Domestic well within 330 feet: ..... yes XX no

Municipal well within one mile: ..... yes XX no

Depth to bottom of fresh water.....

Depth to bottom of usable water..... 150

Surface pipe by Alternate: ..... 1 XX 2

Surface pipe planned to be set..... 20

Conductor pipe required.....

Projected Total Depth..... 800 ..... feet

Formation..... Mississippian

IF OWWO: old well info as follows:

Operator.....

Well Name.....

Comp Date..... Old Total Depth.....

I certify that well will comply with K.S.A. 55-101, et seq., plus eventually plugging hole to KCC specifications.

Date 03/08/88..... Signature of Operator or Agent [Signature] Title AS. Agent

For KCC Use:

Conductor Pipe Required..... feet; Minimum Surface Pipe Required..... 20 feet per Alt. X (2)

This Authorization Expires..... 9-8-88 Approved By..... [Signature] 3-8-88


EFFECTIVE DATE: 3-13-88

Must be filed with the K.C.C. five (5) days prior to commencing well  
This card void if drilling not started within six (6) months of date received by K.C.C.

**Important procedures to follow:**

1. Notify District office before setting surface casing.
2. Set surface casing by circulating cement to the top.
3. File completion forms ACO-1 with K.C.C. within 120 days of well spud date, following instructions on ACO-1, side 1, and including copies of wireline logs.
4. Notify District office 48 hours prior to old well workover or re-entry.
5. Prior to filing Intent, prepare a proposed plugging plan in case well is D & A, then obtain approval of plan when calling district office prior to setting surface pipe.
6. Submit plugging report (CP-4) to K.C.C. after plugging is completed.
7. Obtain an approved injection docket number before disposing of salt water.
8. Notify K.C.C. within 10 days when injection commences or terminates.
9. If an alternate 2 completion, cement in the production pipe from below any usable water to surface within 120 days of spud date.

**A Regular Section of Land  
1 Mile = 5,280 Ft.**

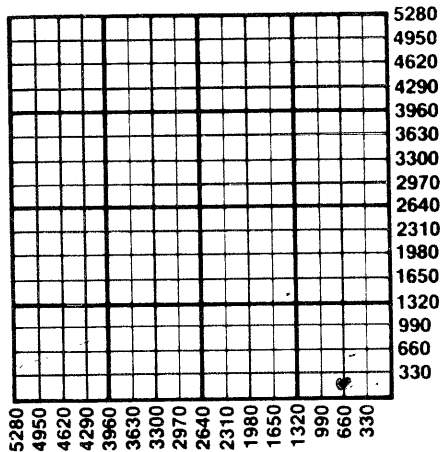

3-8-88

STATE CORPORATION COMMISSION  
MAR 8 1988  
CONSERVATION DIVISION  
Wichita, Kansas

State Corporation Commission of Kansas  
Conservation Division  
200 Colorado Derby Building  
Wichita, Kansas 67202-1212  
(316) 263-3238