CARD MUST BE TYPED

State of Kansas

NOTICE OF INTENTION TO DRILL

(see rules on reverse side)

CANCELLED 3-21-85

CARD MUST BE SIGNED

Starting Date: 3 (month) 13 (day) 85 (year) 2:50

API Number 15- 107-22,515-00-00

OPERATOR: License # 6251

Name Ballou Oil Well Service

Address Route 5 Box 149

City/State/Zip Paola, KS 66701

Contact Person Pat Ballou

Phone 913 294 4777

CONTRACTOR: License # 5938

Name C & M Drilling Enterprises Inc

City/State Paola, KS 66071

SE SE NE/4 (location) Sec 12 Twp 22 S, Rge 21 ☒ East ☐ West

2970 Ft North from Southeast Corner of Section

330 Ft West from Southeast Corner of Section

(Note: Locate well on Section Plat on reverse side)

Nearest lease or unit boundary line 330 feet.

County Linn

Lease Name Frank Weber Well# B-1

Domestic well within 330 feet: ☐ yes ☒ no

Municipal well within one mile: ☐ yes ☒ no

Well Drilled For:	Well Class:	Type Equipment:
☒ Oil ☐ Swd	☒ Infield	☒ Mud Rotary
☐ Gas ☐ Inj	☐ Pool Ext.	☐ Air Rotary
☐ OWWO ☐ Expl	☐ Wildcat	☐ Cable

If OWWO: old well info as follows:

Operator

Well Name

Comp Date Old Total Depth

Depth to Bottom of fresh water 20 feet

Lowest usable water formation

Depth to Bottom of usable water 150 feet

Surface pipe by Alternate: 1 ☐ 2 ☒

Surface pipe to be set 20 feet

Conductor pipe if any required feet

Projected Total Depth 800 feet

Ground surface elevation feet MSL

Projected Formation at TD

This Authorization Expires 9/12/85

Expected Producing Formations

Approved By 3/12/85

I certify that we will comply with K.S.A. 55-101, et seq., plus eventually plugging hole to K.C.C. specifications.

Date 3/12/85 Signature of Operator or Agent Raquel Robles Title As agent


Form C-1 4/84

mHC/KOHE 3-12-85

Must be filed with the K.C.C. five (5) days prior to commencing well
This card void if drilling not started within six (6) months of date received by K.C.C.

CONSERVATION DIVISION
Wichita, Kansas
MAR 12 1985
3-12-85
STATE CORPORATION COMMISSION
RECEIVED

A Regular Section of Land
1 Mile = 5,280 Ft.

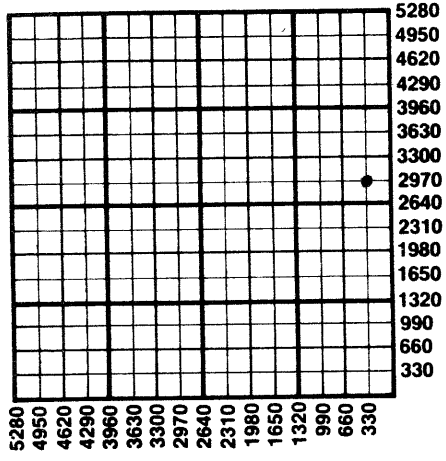

Important procedures to follow:

1. Notify District office before setting surface casing.
2. Set surface casing by circulating cement to the top.
3. File completion forms ACO-1 with K.C.C. within 90 days of well completion, following instructions on ACO-1, side 1, and including copies of wireline logs.
4. Notify District office 48 hours prior to old well workover or re-entry.
5. Prior to plugging, prepare a plugging plan, then obtain agreement from the appropriate district office for an approved plugging plan.
6. Submit plugging report (CP-4) to K.C.C. after plugging is completed.
7. Obtain an approved injection docket number before disposing of salt water.
8. Notify K.C.C. within 10 days when injection commences or terminates.
9. If an alternate 2 completion, cement in the production pipe from below any usable water to surface within 120 days of spud date.

State Corporation Commission of Kansas
Conservation Division
200 Colorado Derby Building
Wichita, Kansas 67202
(316) 263-3238