

CARD MUST BE TYPED

State of Kansas
NOTICE OF INTENTION TO DRILL
(see rules on reverse side)

CORRECTION
CARD MUST BE SIGNED
3-22-85

Starting Date: 3/21/85
month day year

API Number ~~15-107-22~~, 519 - CORRECTION

OPERATOR: License # 5756

NE/4 (location) Sec. 12 Twp. 22 S, Rge. 21 East West

Name Triple I Energy Corp.

Address 6600 College Blvd., #310

City/State/Zip Overland Park, KS 66211

Contact Person Paula

Phone 913-345-8000

* 4620 Ft North from Southeast Corner of Section
1100 Ft West from Southeast Corner of Section
(Note: Locate well on Section Plat on reverse side)

CONTRACTOR: License # 5675

Nearest lease or unit boundary line 660 feet.

County Linn

Name McPherson Drilling CO.

Lease Name Ball Well# 31

City/State Box 308, Cherryvale, KS 66211

Domestic well within 330 feet: yes no

Municipal well within one mile: yes no

Well Drilled For: Well Class: Type Equipment:

- | | | | |
|---|-------------------------------|---|--|
| <input checked="" type="checkbox"/> Oil | <input type="checkbox"/> Swd | <input checked="" type="checkbox"/> Infield | <input checked="" type="checkbox"/> Mud Rotary |
| <input type="checkbox"/> Gas | <input type="checkbox"/> Inj | <input type="checkbox"/> Pool Ext. | <input type="checkbox"/> Air Rotary |
| <input type="checkbox"/> OWWO | <input type="checkbox"/> Expl | <input type="checkbox"/> Wildcat | <input type="checkbox"/> Cable |

If OWWO: old well info as follows:

Operator

Well Name

Comp Date Old Total Depth

Projected Total Depth feet

Projected Formation at TD 900

Expected Producing Formations Mississippi

Depth to Bottom of fresh water 75 feet

Lowest usable water formation Dennis Limestone

Depth to Bottom of usable water 150 feet

Surface pipe by Alternate: 1 2

Surface pipe to be set 20 feet

Conductor pipe if any required feet

Ground surface elevation feet MSL

This Authorization Expires 9-20-85

Approved By 3-20-85

I certify that we will comply with K.S.A. 55-101, et seq., plus eventually plugging hole to K.C.C. specifications. *was* 5060 FSL

Date 3/21/85 Signature of Operator or Agent Susan Arnold

Title As Agent

CONSERVATION DIVISION
Wichita, Kansas


Must be filed with the K.C.C. five (5) days prior to commencing well
This card void if drilling not started within six (6) months of date received by K.C.C.

MAR 21 1985

3-21-85

STATE CORPORATION COMMISSION

A Regular Section of Land
1 Mile = 5,280 Ft.

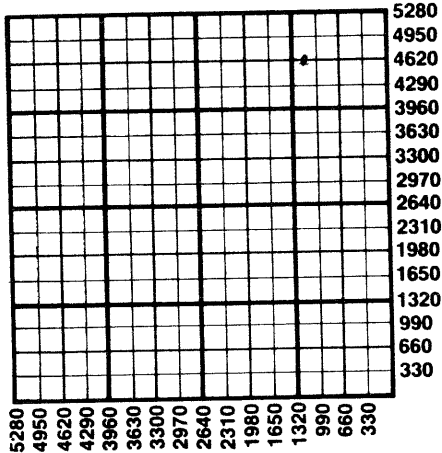

Important procedures to follow :

1. Notify District office before setting surface casing.
2. Set surface casing by circulating cement to the top.
3. File completion forms ACO-1 with K.C.C. within 90 days of well completion, following instructions on ACO-1, side 1, and including copies of wireline logs.
4. Notify District office 48 hours prior to old well workover or re-entry.
5. Prior to plugging, prepare a plugging plan, then obtain agreement from the appropriate district office for an approved plugging plan.
6. Submit plugging report (CP-4) to K.C.C. after plugging is completed.
7. Obtain an approved injection docket number before disposing of salt water.
8. Notify K.C.C. within 10 days when injection commences or terminates.
9. If an alternate 2 completion, cement in the production pipe from below any usable water to surface within 120 days of spud date.

State Corporation Commission of Kansas
Conservation Division
200 Colorado Derby Building
Wichita, Kansas 67202
(316) 263-3238