

CARD MUST BE TYPED

State of Kansas

CARD MUST BE SIGNED

## NOTICE OF INTENTION TO DRILL

(see rules on reverse side)

Expected Spud Date. .... 8 24 1988  
                                          month      day      year

OPERATOR: License # ..... 9102  
 Name ..... MICO OIL & GAS, INC.  
 Address ..... P.O. Box 281  
 City/State/Zip ..... Paola, Kansas 66071  
 Contact Person ..... Ernie D. Pratt  
 Phone ..... (913) 755-2128

CONTRACTOR: License # ..... 6142  
 Name ..... Town Oil Company  
 City/State ..... Paola, Kansas 66071

Well Drilled For:      Well Class:      Type Equipment:  
☒ Oil      \_\_\_ Storage      \_\_\_ Infield      ☒ Mud Rotary  
 \_\_\_ Gas      \_\_\_ Inj      ☒ Pool Ext.      \_\_\_ Air Rotary  
 \_\_\_ OWWO      \_\_\_ Expl      \_\_\_ Wildcat      \_\_\_ Cable

If OWWO: old well info as follows:

Operator .....  
 Well Name .....  
 Comp Date ..... Old Total Depth .....

I certify that well will comply with K.S.A. 55-101, et seq., plus eventually plugging hole to KCC specifications.

Date ... 8-19-88 ... Signature of Operator or Agent *Frank G. ...* Title ..... Agent .....

For KCC Use:

Conductor Pipe Required ..... feet; Minimum Surface Pipe Required ..... feet per Alt. ☒ (2)  
 This Authorization Expires ... 2-19-89 ... Approved By *LKM* 8-19-88

EFFECTIVE DATE: 8-24-88

API Number 15- *107-23,011* *6-00-00*  
 NE. NE. NE. Sec. 13 Twp. 22 S, Rg. 21 ☒ East  
 5115 \_\_\_\_\_ Ft. from South Line of Section  
 165 \_\_\_\_\_ Ft. from East Line of Section

(Note: Locate well on Section Plat on reverse side)

Nearest lease or unit boundary line ..... 165 ..... feet  
 County ..... LINN

Lease Name ..... CALKINS Well # ..... 1-88

Ground surface elevation ..... feet MSL

Domestic well within 330 feet: \_\_\_ yes ☒ noMunicipal well within one mile: \_\_\_ yes ☒ no

Depth to bottom of fresh water ..... 28' 40"

Depth to bottom of usable water ..... 150

Surface pipe by Alternate: 1 \_\_\_ 2 ☒

Surface pipe planned to be set ..... 20

Conductor pipe required ..... None


Projected Total Depth ..... 750 ..... feet

Formation ..... Bartlesville

Must be filed with the K.C.C. five (5) days prior to commencing well  
This card void if drilling not started within six (6) months of date received by K.C.C.

**Important procedures to follow:**

1. Notify District office before setting surface casing.
2. Set surface casing by circulating cement to the top.
3. File completion forms ACO-1 with K.C.C. within 120 days of well spud date, following instructions on ACO-1, side 1, and including copies of wireline logs.
4. Notify District office 48 hours prior to old well workover or re-entry.
5. Prior to filing Intent, prepare a proposed plugging plan in case well is D & A, then obtain approval of plan when calling district office prior to setting surface pipe.
6. Submit plugging report (CP-4) to K.C.C. after plugging is completed.
7. Obtain an approved injection docket number before disposing of salt water.
8. Notify K.C.C. within 10 days when injection commences or terminates.
9. If an alternate 2 completion, cement in the production pipe from below any usable water to surface within 120 days of spud date.

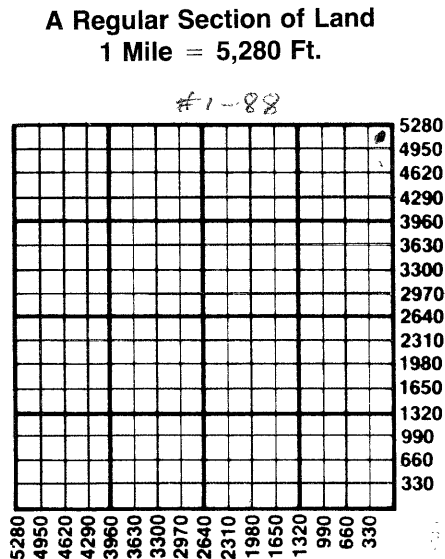

8-19-88

AUG 19 1988

State Corporation Commission  
Wichita, Kansas

State Corporation Commission of Kansas  
Conservation Division  
200 Colorado Derby Building  
Wichita, Kansas 67202-1212  
(316) 263-3238