

CARD MUST BE TYPED

State of Kansas

CARD MUST BE SIGNED

### NOTICE OF INTENTION TO DRILL

(see rules on reverse side)

Expected Spud Date. .... 4 18 1988  
month day year

API Number 15— 107-22.990-00-00 <sup>VO</sup>

OPERATOR: License # ..... 9460  
Name ..... OSCI OIL & GAS, INC.  
Address ..... RR #1 BOX 54  
City/State/Zip ..... Centerville, Kansas 66014  
Contact Person ..... Mike Eastwood  
Phone ..... (913) 898-4082

NE SE SE Sec. 14 Twp. 22 S, Rg. 21 X East  
1210 \_\_\_\_\_ West  
165 \_\_\_\_\_ Ft. from South Line of Section  
\_\_\_\_\_ Ft. from East Line of Section

(Note: Locate well on Section Plat on reverse side)

CONTRACTOR: License # ..... 6451  
Name ..... Big "E" Drilling  
City/State ..... Centerville, Kansas 66014

Nearest lease or unit boundary line ..... 165 feet  
County ..... LINN  
Lease Name ..... MILLER Well # 10-88

Well Drilled For: Well Class: Type Equipment:  
X Oil \_\_\_\_\_ Storage X Infield \_\_\_\_\_ Mud Rotary  
\_\_\_\_\_ Gas \_\_\_\_\_ Inj \_\_\_\_\_ Pool Ext. X Air Rotary  
\_\_\_\_\_ OWWO \_\_\_\_\_ Expl \_\_\_\_\_ Wildcat \_\_\_\_\_ Cable

Ground surface elevation ..... feet MSL  
Domestic well within 330 feet: \_\_\_\_\_ yes X no  
Municipal well within one mile: \_\_\_\_\_ yes X no  
Depth to bottom of fresh water ..... 20  
Depth to bottom of usable water ..... 150

If OWWO: old well info as follows:

Operator .....  
Well Name .....  
Comp Date ..... Old Total Depth.....

Surface pipe by Alternate: 1 \_\_\_\_\_ 2 X  
Surface pipe planned to be set ..... 20  
Conductor pipe required ..... None  
Projected Total Depth ..... 900 feet  
Formation ..... Mississippi

I certify that well will comply with K.S.A. 55-101, et seq., plus eventually plugging hole to KCC specifications.

Date .. 4-13-88 ..... Signature of Operator or Agent *Frank Brantford* Title ..... Agent

For KCC Use:

Conductor Pipe Required ..... feet; Minimum Surface Pipe Required ..... 20 feet per Alt. X (2)  
This Authorization Expires ..... 10-13-88 ..... Approved By *DB* 4-13-88


EFFECTIVE DATE: 4-18-88

Must be filed with the K.C.C. five (5) days prior to commencing well  
This card void if drilling not started within six (6) months of date received by K.C.C.

**Important procedures to follow:**

1. Notify District office before setting surface casing.
2. Set surface casing by circulating cement to the top.
3. File completion forms ACO-1 with K.C.C. within 120 days of well spud date, following instructions on ACO-1, side 1, and including copies of wireline logs.
4. Notify District office 48 hours prior to old well workover or re-entry.
5. Prior to filing Intent, prepare a proposed plugging plan in case well is D & A, then obtain approval of plan when calling district office prior to setting surface pipe.
6. Submit plugging report (CP-4) to K.C.C. after plugging is completed.
7. Obtain an approved injection docket number before disposing of salt water.
8. Notify K.C.C. within 10 days when injection commences or terminates.
9. If an alternate 2 completion, cement in the production pipe from below any usable water to surface within 120 days of spud date.

**A Regular Section of Land  
1 Mile = 5,280 Ft.**

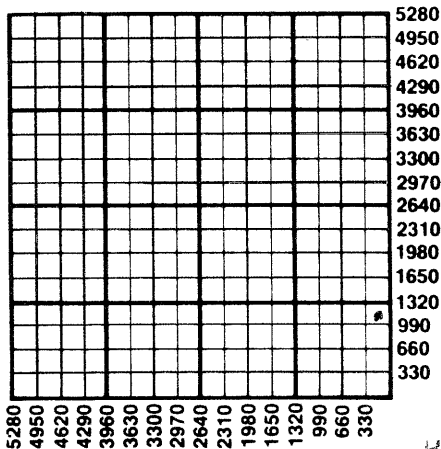

RECEIVED  
STATE CORPORATION COMMISSION

4-13-88

APR 13 1988

CONSERVATION DIVISION

State Corporation Commission of Kansas  
Conservation Division  
200 Colorado Derby Building  
Wichita, Kansas 67202-1212  
(316) 263-3238