

CARD MUST BE TYPED

State of Kansas

CARD MUST BE SIGNED

### NOTICE OF INTENTION TO DRILL

(see rules on reverse side)

Expected Spud Date..... 4 18 1988  
month day year

API Number 15-107-22992-00-00

OPERATOR: License #..... 9460  
Name..... OSCI OIL & GAS INC.  
Address..... RR #1 BOX 54  
City/State/Zip..... Centerville, Kansas 66014  
Contact Person..... Mike Eastwood  
Phone..... (913) 898-4082

NE. SE. SE. Sec. 14... Twp... 22 S, Rg... 21  East  
1210 \_\_\_\_\_ Ft. from South Line of Section  
495 \_\_\_\_\_ Ft. from East Line of Section

(Note: Locate well on Section Plat on reverse side)

CONTRACTOR: License #..... 6451  
Name..... Big "E" Drilling  
City/State..... Centerville, Kansas 66014

Nearest lease or unit boundary line ..... 495 feet  
County..... LINN  
Lease Name..... MILLER Well #..... 12-88

Well Drilled For: Well Class: Type Equipment:  
 Oil \_\_\_\_\_ Storage  Infield \_\_\_\_\_ Mud Rotary  
\_\_\_\_\_ Gas \_\_\_\_\_ Inj \_\_\_\_\_ Pool Ext.  Air Rotary  
\_\_\_\_\_ OWWO \_\_\_\_\_ Expl \_\_\_\_\_ Wildcat \_\_\_\_\_ Cable

Ground surface elevation ..... feet MSL  
Domestic well within 330 feet: \_\_\_\_\_ yes  no  
Municipal well within one mile: \_\_\_\_\_ yes  no  
Depth to bottom of fresh water..... 20  
Depth to bottom of usable water ..... 150  
Surface pipe by Alternate: 1 \_\_\_\_\_ 2   
Surface pipe planned to be set ..... 20  
Conductor pipe required ..... None  
Projected Total Depth ..... 900 feet  
Formation..... Mississippi

IF OWWO: old well info as follows:

Operator .....  
Well Name .....  
Comp Date..... Old Total Depth.....

I certify that well will comply with K.S.A. 55-101, et seq., plus eventually plugging hole to KCC specifications.

Date 4-13-88 Signature of Operator or Agent *Orval Brundage* Title..... Agent

For KCC Use:

Conductor Pipe Required ..... feet; Minimum Surface Pipe Required ..... 20 feet per Alt.  (2)  
This Authorization Expires 10-13-88 Approved By *Orval* 4-13-88


EFFECTIVE DATE: 4-18-88

Must be filed with the K.C.C. five (5) days prior to commencing well  
 This card void if drilling not started within six (6) months of date received by K.C.C.

**Important procedures to follow:**

1. Notify District office before setting surface casing.
2. Set surface casing by circulating cement to the top.
3. File completion forms ACO-1 with K.C.C. within 120 days of well spud date, following instructions on ACO-1, side 1, and including copies of wireline logs.
4. Notify District office 48 hours prior to old well workover or re-entry.
5. Prior to filing Intent, prepare a proposed plugging plan in case well is D & A, then obtain approval of plan when calling district office prior to setting surface pipe.
6. Submit plugging report (CP-4) to K.C.C. after plugging is completed.
7. Obtain an approved injection docket number before disposing of salt water.

**A Regular Section of Land  
 1 Mile = 5,280 Ft.**

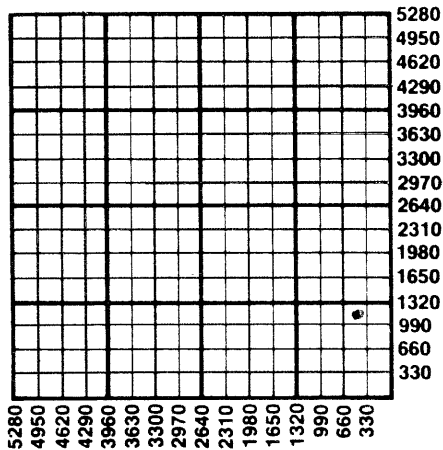

8. Notify K.C.C. within 10 days when injection commences or terminates.

RECEIVED  
 STATE CORPORATION COMMISSION

9. If an alternate 2 completion, cement in the production pipe from below any usable water to surface within 120 days of spud date.

CONSERVATION DIVISION  
 Wichita, Kansas

473-88

State Corporation Commission of Kansas  
 Conservation Division  
 200 Colorado Derby Building  
 Wichita, Kansas 67202-1212  
 (316) 263-3238