


Give All Information Completely
Make Required Affidavit
Mail or Deliver Report to:
Conservation Division
State Corporation Commission
212 North Market, Insurance Bldg.
Wichita, Kansas

WELL PLUGGING RECORD

Osborne County. Sec. 21 Twp. 10S Rge. 11 (E) W(W)

Location as "NE/CNW/SW" or footage from lines C SE SW
Lease Owner Drolte & Christopher et al.
Lease Name Mosher Well No. 1
Office Address 624 Petroleum Building, Amarillo, Texas
Character of Well (completed as Oil, Gas or Dry Hole) Dry Hole
Date well completed June 7 1959
Application for plugging filed June 7 1959
Application for plugging approved June 7 1959
Plugging commenced June 7 1959
Plugging completed June 7 1959
Reason for abandonment of well or producing formation Dry

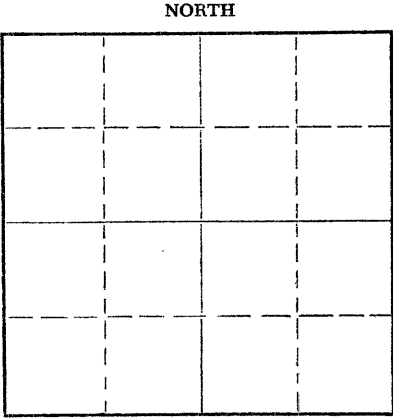

Locate well correctly on above Section Plat

If a producing well is abandoned, date of last production 19
Was permission obtained from the Conservation Division or its agents before plugging was commenced? Yes

Name of Conservation Agent who supervised plugging of this well Lou Brock - Great Bend, Kansas
Producing formation _____ Depth to top _____ Bottom _____ Total Depth of Well 3975' Feet
Show depth and thickness of all water, oil and gas formations.

OIL, GAS OR WATER RECORDS

CASING RECORD

FORMATION	CONTENT	FROM	TO	SIZE	SET IN	PULLED OUT
				8 5/8"	181' 181'	None

Describe in detail the manner in which the well was plugged, indicating where the mud fluid was placed and the method or methods used in introducing it into the hole. If cement or other plugs were used, state the character of same and depth placed, from _____ feet to _____ feet for each plug set.

Cemented bottom plug @ 160' with 20 sacks
Cemented top plug @ 35' with 10 sacks

RECEIVED
STATE CORPORATION COMMISSION
JUN 10 1959
06-10-1959
CONSERVATION DIVISION
Wichita, Kansas

(If additional description is necessary, use BACK of this sheet)
Name of Plugging Contractor Hilton Drilling Company, Inc.
Address 925 Patton Road, Great Bend, Kansas

STATE OF KANSAS, COUNTY OF BARTON, ss.
Henry Peacock - Land Manager (employee of owner) or (owner or operator) of the above-described well, being first duly sworn on oath, says: That I have knowledge of the facts, statements, and matters herein contained and the log of the above-described well as filed and that the same are true and correct. So help me God.

(Signature) Henry Peacock
Great Bend, Kansas
(Address)

SUBSCRIBED AND SWORN TO before me this 9th day of June, 19 59

My commission expires January 26, 1963
Carmen Reinhardt Leiker Notary Public.

PLUGGING
FILE SEC. 21 T. 10 R. W
BOOK PAGE 45 LINE 15

D R I L L E R ' S L O G

15-141-00002-00-00

COMPANY:	DROLTE & CHRISTOPHER ET AL	LOCATION:	6 SE SW
CONTRACTOR:	HILTON DRILLING COMPANY, INC.		SECTION 21-10-11
			OSBORNE COUNTY, KANSAS
FARM NAME:	MOSHER #1	ELEVATION:	1685' DF
COMMENCED:	MAY 25, 1959	CASING USED:	8 5/8" @ 181' WITH
COMPLETED:	JUNE 7, 1959		175 SACKS

SHALE AND POST ROCK	85
SHALE AND SHELLS	683
ANHYDRITE	720
SHALE	1015
SHALE AND SHELLS	1320
LIME AND SHALE	1835
LIME AND SAND	1915
LIME AND SHALE	2921
LIME	3223
LIME AND SHALE	3482
SHALE AND CHERT	3490
CHERT	3544
LIME AND SHALE	3560
SHALE AND CHERT	3610
SHALE AND SAND	3725
LIME	3758
LIME AND SHALE	3935
LIME, SAND AND SHALE	3957
LIME	3975
TOTAL DEPTH	3975

RECEIVED
STATE DEPARTMENT OF CONSERVATION
JUN 10 1959
CONSERVATION DIVISION
Wichita, Kansas
06-10-1959

STATE OF KANSAS)
) ss.
COUNTY OF BARTON)

I, THE UNDERSIGNED, BEING DULY SWORN ON OATH, STATE THAT THE ABOVE STATEMENT AND LOG ARE TRUE AND A CORRECT RECORD AND LOG OF THE WELL DRILLED AT THE LOCATION ABOVE DESCRIBED.

HILTON DRILLING COMPANY, INC.

Henry Peacock
HENRY PEACOCK - LAND DEPARTMENT

SUBSCRIBED AND SWORN TO BEFORE ME THIS 9TH DAY OF JUNE, 1959:

Carmen Reinhardt Leiker
CARMEN REINHARDT LEIKER, NOTARY PUBLIC

MY COMMISSION EXPIRES JANUARY 26, 1963

PLUGGING
FILE SEC. 21, T. 10, R. 11W
BOOK PAGE 45 LINE 15