


STATE OF KANSAS
STATE CORPORATION COMMISSION

15-141-00045-00-00

WELL PLUGGING RECORD

Give All Information Completely
Make Required Affidavit
Mail or Deliver Report to:
Conservation Division
State Corporation Commission
800 Biting Building
Wichita, Kansas

NORTH

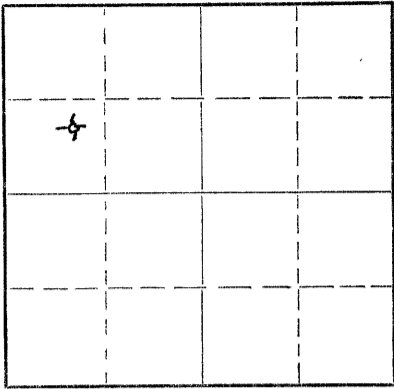

Locate well correctly on above
Section Plat

Osborne County. Sec. 26 Twp. 10S Rge. 15 (E) W (W)
Location as "NE/CNW $\frac{1}{4}$ SW $\frac{1}{4}$ " or footage from lines NE/4 SW/4 NW/4
Lease Owner Anderson-Prichard Oil Corporation
Lease Name Worley Well No. 1
Office Address Liberty Bank Bldg., Oklahoma City, Oklahoma
Character of Well (completed as Oil, Gas or Dry Hole) Dry
Date well completed February 28 19 53
Application for plugging filed February 28 19 53
Application for plugging approved February 28 19 53
Plugging commenced February 28 19 53
Plugging completed February 28 19 53
Reason for abandonment of well or producing formation Dry

If a producing well is abandoned, date of last production _____ 19____
Was permission obtained from the Conservation Division or its agents before plugging was commenced? Yes

Name of Conservation Agent who supervised plugging of this well Eldon Petty
Producing formation _____ Depth to top _____ Bottom _____ Total Depth of Well 3440 Feet
Show depth and thickness of all water, oil and gas formations.

OIL, GAS OR WATER RECORDS

CASING RECORD

FORMATION	CONTENT	FROM	TO	SIZE	PUT IN	PULLED OUT
		0'	200'	8 5/8"	200'	None

Describe in detail the manner in which the well was plugged, indicating where the mud fluid was placed and the method or methods used in introducing it into the hole. If cement or other plugs were used, state the character of same and depth placed, from _____ feet to _____ feet for each plug set.

From 3440' - 196 $\frac{1}{2}$ ' - Heavy Rotary Mud
196 $\frac{1}{2}$ ' - 195' - Wooden Plug
195' - 133' - 20 Sacks cement & $\frac{1}{2}$ Sks. Hulls
133' - 36 $\frac{1}{2}$ ' - Heavy Rotary Mud
36 $\frac{1}{2}$ ' - 35' - Wooden Plug
35' - 6' - 10 sacks cement & $\frac{1}{2}$ sk. Hulls
6' - to Surface - Cellar

Received
STATE CORPORATION COMMISSION
3-6-53
MAR - 6 1953

CONSERVATION DIVISION
Wichita, Kansas

(If additional description is necessary, use BACK of this sheet)

Name of Plugging Contractor Glenn W. Peel
Address P. O. Box 359 Hoisington, Kansas

STATE OF Kansas, COUNTY OF Barton, ss.
Glenn W. Peel (employee of owner) or (owner/contractor) of the above-described well, being first duly sworn on oath, says: That I have knowledge of the facts, statements, and matters herein contained and the log of the above-described well as filed and that the same are true and correct. So help me God. GLENN W. PEEL

(Signature) BY: *Glenn W. Peel*
P. O. BOX 359
HOISINGTON, KANSAS
(Address)

SUBSCRIBED AND SWORN TO before me this 4th day of March, 1953
Marian M. Herbert
Notary Public.

My commission expires June 4, 1955

PLUGGING
FILE SEC 26 T 10 R 15
BOOK PAGE 21 LINE 41

DRILLER'S LOG

Company: Anderson-Prichard Oil Corp.

NE/4 SW/4 NW/4
Sec. 26 Twp. 10S Rge. 15W

Farm: Worley Well No. 1

County: Osborne,
Kansas

Total Depth: 3440'

Comm: 2-16-53 Comp: 2-28-53
Contractor: Glenn W. Peel

Elevation:

Casing: 8 5/8" - 200' cem.

Production: Dry

Figures below indicate bottom of formations:

Surface Clay and sands	0 -	200'
Shale		400
Sand		530
Shale & Sand		800
Shale		960
Anhydrite		995
Shale & Shells		1330
Shale		1600
Shale & Lime		1880
Lime & Shale		1950
Lime		2710
Total Depth		3440
		3440'

This is to certify that the above information is to the best of my knowledge true and correct.

GLENN W. PEEL

BY: *Glenn W. Peel*

SUBSCRIBED AND SWORN to before me this 4th day of March, 1953

My commission expires June 4, 1955

Marion M. Herbert
Notary Public

RECEIVED
STATE GEOLOGICAL SURVEY
3-6-53
CONSERVATION DIVISION
Wichita, Kansas

PLUGGING
FILE SEC-26 T 10 R 1524
BOOK PAGE 81 LINE 41