

CARD MUST BE TYPED

State of Kansas

CARD MUST BE SIGNED

NOTICE OF INTENTION TO DRILL

(see rules on reverse side)

Starting Date 9¹⁴ / 8 / 85
month day year

API Number 15— 107-22,731-00-00

OPERATOR: License # 5756
Name Triple I Energy Corp.
Address 6600 College Blvd. # 310
City/State/Zip Overland Park, KS 66211
Contact Person Lila Highfill
Phone 913-345-8000

app. NW. NE NE Sec. 12 Twp. 22 S, Rg. 21 East
..... 4840 Ft. from South Line of Section
..... 1290 Ft. from East Line of Section

(Note: Locate well on Section Plat on reverse side)

CONTRACTOR: License #
Name Unknown
City/State

Nearest lease or unit boundary line 440 feet
County Linn
Lease Name Ball "A" Well # 39-W

Well Drilled For: Well Class: Type Equipment:
___ Oil ___ SWD ___ Infield ___ Mud Rotary
___ Gas ___ Inj ___ Pool Ext. ___ Air Rotary
___ OWWO ___ Expl ___ Wildcat ___ Cable

Ground surface elevation na feet MSL
Domestic well within 330 feet: ___ yes ___ no
Municipal well within one mile: ___ yes ___ no
Surface pipe by Alternate: 1 ___ 2 ___

If OWWO: old well info as follows:
Operator
Well Name
Comp Date Old Total Depth

Depth to bottom of fresh water 75
Depth to bottom of usable water 150
Surface pipe planned to be set 20
Projected Total Depth 900 feet
Formation Mississippian

I certify that well will comply with K.S.A. 55-101, et seq., plus eventually plugging hole to KCC specifications.

_____ cementing will be done immediately upon setting production casing.
Date 9/6/85. Signature of Operator or Agent *Susan Arnold* Title As Agent

For KCC Use:

Conductor Pipe Required feet; Minimum Surface Pipe Required feet per ft. 1 2
This Authorization Expires 3-7-86 Approved By 9-9-85

Must be filed with the K.C.C. five (5) days prior to commencing well
 This card void if drilling not started within six (6) months of date received by K.C.C.

9-6-88


RECEIVED
 STATE CORPORATION COMMISSION

Important procedures to follow:

A Regular Section of Land
1 Mile = 5,280 Ft.

SEP 6 1988

CONSERVATION DIVISION
 Wichita, Kansas

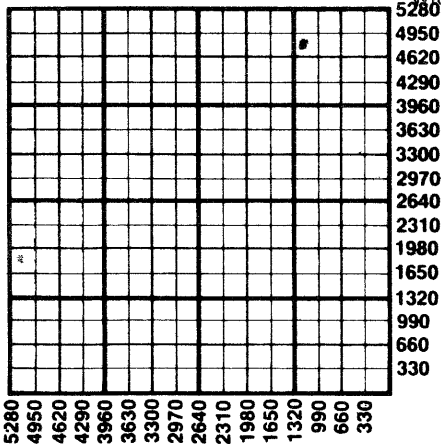

1. Notify District office before setting surface casing.
2. Set surface casing by circulating cement to the top.
3. File completion forms ACO-1 with K.C.C. within 90 days of well completion, following instructions on ACO-1, side 1, and including copies of wireline logs.
4. Notify District office 48 hours prior to old well workover or re-entry.
5. Prior to filing Intent, prepare a proposed plugging plan in case well is D & A, then obtain approval of plan when calling district office prior to setting surface pipe.
6. Submit plugging report (CP-4) to K. C. C. after plugging is completed.
7. Obtain an approved injection docket number before disposing of salt water.
8. Notify K.C.C. within 10 days when injection commences or terminates.
9. If an alternate 2 completion, cement in the production pipe from below any usable water to surface within 120 days of spud date.

State Corporation Commission of Kansas
 Conservation Division
 200 Colorado Derby Building
 Wichita, Kansas 67202
 (316) 263-3238