

CARD MUST BE TYPED

State of Kansas

CARD MUST BE SIGNED

NOTICE OF INTENTION TO DRILL

(see rules on reverse side)

Starting Date 9¹⁴ / 6 / 85
month day year

API Number 15— 107-22,732-0000

OPERATOR: License # 5756 app.
Name Triple E Energy Corp.
Address 6600 College Blvd. # 310
City/State/Zip Overland Park, KS 66211
Contact Person Lila Highfill
Phone 913-345-8000

_____ East
NW NE NE Sec. 12. Twp. 22 S, Rg. 21. _____ West
..... 4840 Ft. from South Line of Section
..... 880 Ft. from East Line of Section

(Note: Locate well on Section Plat on reverse side)

CONTRACTOR: License #
Name Unknown
City/State

Nearest lease or unit boundary line 440 feet
County Lincoln
Lease Name Ball "A" Well # 40-W
Ground surface elevation na feet MSL

Well Drilled For: Well Class: Type Equipment:
___ Oil ___ SWD ___ X Infield ___ Mud Rotary
___ Gas ___ Int. ___ Pool Ext. ___ Air Rotary
___ OWWO ___ Expl ___ Wildcat ___ Cable

Domestic well within 330 feet: _____ yes _____ no
Municipal well within one mile: _____ yes _____ no
Surface pipe by Alternate: 1 2 _____

If OWWO: old well info as follows:
Operator
Well Name
Comp Date Old Total Depth

Depth to bottom of fresh water 7.5
Depth to bottom of usable water 1.50
Surface pipe planned to be set 2.0
Projected Total Depth 900 feet
Formation Mississippian

I certify that well will comply with K.S.A. 55-101, et seq., plus eventually plugging hole to KCC specifications.

_____ cementing will be done immediately upon setting production casing.

PCA for KOME

Date 9/6/85 .. Signature of Operator or Agent .. Susan Orndorff Title As Agent

For KCC Use:

Conductor Pipe Required feet; Minimum Surface Pipe Required feet per Alt. 1 2

This Authorization Expires 3-9-86 Approved By 9-9-85

Must be filed with the K.C.C. five (5) days prior to commencing well
This card void if drilling not started within six (6) months of date received by K.C.C.

Important procedures to follow:


Q-6-85

RECEIVED
STATE CORPORATION COMMISSION

A Regular Section of Land
1 Mile = 5,280 Ft.

SEP 6 1985

CONSERVATION DIVISION
Wichita, Kansas

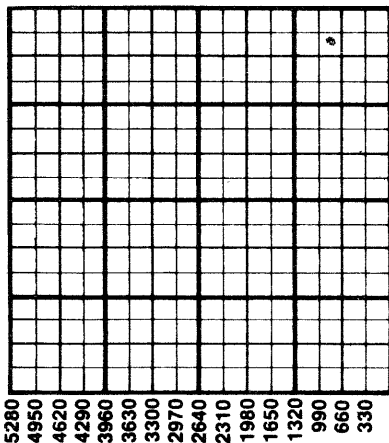

1. Notify District office before setting surface casing.
2. Set surface casing by circulating cement to the top.
3. File completion forms ACO-1 with K.C.C. within 90 days of well completion, following instructions on ACO-1, side 1, and including copies of wireline logs.
4. Notify District office 48 hours prior to old well workover or re-entry.
5. Prior to filing Intent, prepare a proposed plugging plan in case well is D & A, then obtain approval of plan when calling district office prior to setting surface pipe.
6. Submit plugging report (CP-4) to K.C.C. after plugging is completed.
7. Obtain an approved injection docket number before disposing of salt water.
8. Notify K.C.C. within 10 days when injection commences or terminates.
9. If an alternate 2 completion, cement in the production pipe from below any usable water to surface within 120 days of spud date.

State Corporation Commission of Kansas
Conservation Division
200 Colorado Derby Building
Wichita, Kansas 67202
(316) 263-3238