

CARD MUST BE TYPED

State of Kansas

CARD MUST BE SIGNED

NOTICE OF INTENTION TO DRILL

(see rules on reverse side)

Starting Date October 11 1985
month day year 4:00

API Number 15— 107-22,768-00-00
x ___ East

OPERATOR: License # 5756
Name Triple I Energy Corporation
Address 6600 College Blvd., #301
City/State/Zip Overland Park, KS 66211
Contact Person Lila Highfill
Phone 913 345 8000

App. SW NE NE Sec 12 Twp 22 S, Rg. 21
4125
1100
Ft. from South Line of Section
Ft. from East Line of Section

(Note: Locate well on Section Plat on reverse side)

CONTRACTOR: License # 9605
Name Rusty's Drilling
City/State Chanute, Kansas 66720

Nearest lease or unit boundary line 1100 feet
County Linn
Lease Name Ball "A" Well # WS-1

Well Drilled For: Well Class: Type Equipment:
___ Oil ___ SWD Infield Mud Rotary
___ Gas ___ Inj ___ Pool Ext. ___ Air Rotary
___ OWWO ___ Expl ___ Wildcat ___ Cable

Ground surface elevation feet MSL
Domestic well within 330 feet: ___ yes no
Municipal well within one mile: ___ yes no
Surface pipe by Alternate: 1 ___ 2
Depth to bottom of fresh water 75
Depth to bottom of usable water 150
Surface pipe planned to be set 20
Projected Total Depth 900 feet
Formation Mississippi

If OWWO: old well info as follows: wtr. Sup. X
Operator
Well Name
Comp Date Old Total Depth

I certify that well will comply with K.S.A. 55-101, et seq., plus eventually plugging hole to KCC specifications.

_____ cementing will be done immediately upon setting production casing.

Date 10/10/85. Signature of Operator or Agent *Elaine Barkman* Title As agent

For KCC Use:

Conductor Pipe Required feet; Minimum Surface Pipe Required feet per Mt. 1 2
This Authorization Expires 4-10-86 Approved By 10-10-85 *R*

Must be filed with the K.C.C. five (5) days prior to commencing well
This card void if drilling not started within six (6) months of date received by K.C.C.


10-10-85

RECEIVED
STATE CORPORATION COMMISSION

Important procedures to follow:

A Regular Section of Land **OCT 10 1985**
1 Mile = 5,280 Ft.

CONSERVATION DIVISION
Wichita, Kansas

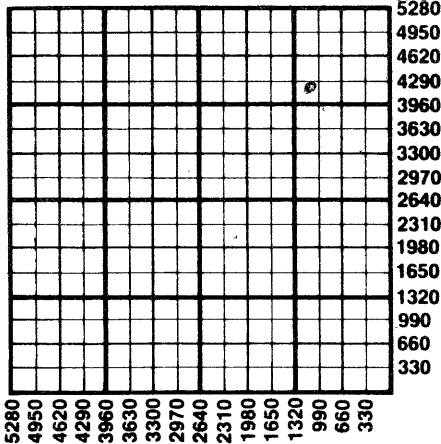

1. Notify District office before setting surface casing.
2. Set surface casing by circulating cement to the top.
3. File completion forms ACO-1 with K.C.C. within 90 days of well completion, following instructions on ACO-1, side 1, and including copies of wireline logs.
4. Notify District office 48 hours prior to old well workover or re-entry.
5. Prior to filing Intent, prepare a proposed plugging plan in case well is D & A, then obtain approval of plan when calling district office prior to setting surface pipe.
6. Submit plugging report (CP-4) to K.C.C. after plugging is completed.
7. Obtain an approved injection docket number before disposing of salt water.
8. Notify K.C.C. within 10 days when injection commences or terminates.
9. If an alternate 2 completion, cement in the production pipe from below any usable water to surface within 120 days of spud date.

State Corporation Commission of Kansas
Conservation Division
200 Colorado Derby Building
Wichita, Kansas 67202
(316) 263-3238