

CARD MUST BE TYPED

State of Kansas

CARD MUST BE SIGNED

NOTICE OF INTENTION TO DRILL

(see rules on reverse side)

Expected Spud Date. OCTOBER 13, 1987
month day year

OPERATOR: License # #5756

Name TRIPLE I OPERATING, INC.

Address 8880 WARD PARKWAY #200

City/State/Zip KANSAS CITY, MO 64114

Contact Person DAVID COEN

Phone (913) 448-6331

CONTRACTOR: License #

Name UNKNOWN

City/State

Well Drilled For: Well Class: Type Equipment:

Oil Storage Infield Mud Rotary

Gas Inj Pool Ext. Air Rotary

OWWO Expl Wildcat Cable

If OWWO: old well info as follows:

Operator

Well Name

Comp Date Old Total Depth

I certify that well will comply with K.S.A. 55-101, et seq., plus eventually plugging hole to KCC specifications.

Date 10/8/87 Signature of Operator or Agent Greg Engler Title AS AGENT

For KCC Use:

Conductor Pipe Required feet; Minimum Surface Pipe Required 20 feet per Alt. X 2

This Authorization Expires 10-8-88 effective 10-13-87 Approved By 10-8-87

API Number 15- 107-22,921-00-00 Inj

SE SW NE Sec. 12 Twp. 22 S, Rg. 21 East West

3080 Ft. from South Line of Section
1750 Ft. from East Line of Section

(Note: Locate well on Section Plat on reverse side)

Nearest lease or unit boundary line 440 feet

County LINN

Lease Name WEBER C Well # W-10-0

Ground surface elevation feet MSL

Domestic well within 330 feet: yes no

Municipal well within one mile: yes no

Depth to bottom of fresh water

Depth to bottom of usable water 150

Surface pipe by Alternate: 1 2

Surface pipe planned to be set 20

Conductor pipe required

Projected Total Depth 800 feet


Formation BORGESS

Must be filed with the K.C.C. five (5) days prior to commencing well
This card void if drilling not started within six (6) months of date received by K.C.C.

Important procedures to follow:

1. Notify District office before setting surface casing.
2. Set surface casing by circulating cement to the top.
3. File completion forms ACO-1 with K.C.C. within 120 days of well spud date, following instructions on ACO-1, side 1, and including copies of wireline logs.
4. Notify District office 48 hours prior to old well workover or re-entry.
5. Prior to filing Intent, prepare a proposed plugging plan in case well is D & A, then obtain approval of plan when calling district office prior to setting surface pipe.
6. Submit plugging report (CP-4) to K.C.C. after plugging is completed.
7. Obtain an approved injection docket number before disposing of salt water.
8. Notify K.C.C. within 10 days when injection commences or terminates.
9. If an alternate 2 completion, cement in the production pipe from below any usable water to surface within 120 days of spud date.

A Regular Section of Land 1 Mile = 5,280 Ft.

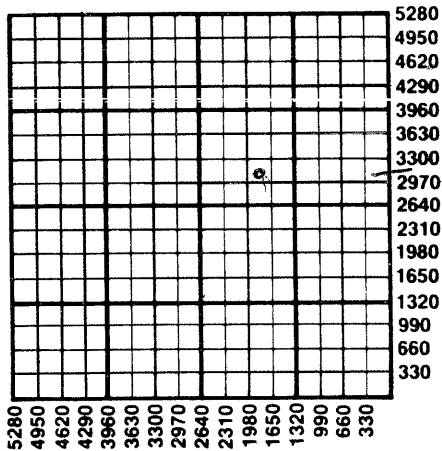

10-8-87

RECEIVED
STATE CORPORATION COMMISSION
OCT 8 1987
CONSERVATION DIVISION
Wichita, Kansas
State Corporation Commission of Kansas
Conservation Division
200 Colorado Derby Building
Wichita, Kansas 67202-1212
(316) 263-3238