

CARD MUST BE TYPED

State of Kansas

CARD MUST BE SIGNED

### NOTICE OF INTENTION TO DRILL

(see rules on reverse side)

Expected Spud Date... OCTOBER 13, 1987  
month day year

OPERATOR: License # #5756  
Name TRIPLE I OPERATING, INC.  
Address 8880 WARD PARKWAY #200  
City/State/Zip KANSAS CITY, MO 64114  
Contact Person DAVID COEN  
Phone (913) 448-6331

CONTRACTOR: License #  
Name UNKNOWN  
City/State .....

Well Drilled For: Well Class: Type Equipment:  
 Oil  Storage  Infield  Mud Rotary  
 Gas  Inj  Pool Ext.  Air Rotary  
 OWWO  Expl  Wildcat  Cable

If OWWO: old well info as follows:  
Operator .....  
Well Name .....  
Comp Date ..... Old Total Depth.....

I certify that well will comply with K.S.A. 55-101, et seq., plus eventually plugging hole to KCC specifications.  
Date 10/8/87 Signature of Operator or Agent ..... Title. AS AGENT

For KCC Use:  
Conductor Pipe Required ..... feet; Minimum Surface Pipe Required ..... feet per Alt. 20  
This Authorization Expires 4-8-88 effective Approved By DCW 10-8-87 10-13-87

API Number 15- 107-22, 922-00-00 INS  
SW SW N13 26  
Sec. 12 Twp. 22 S, Rg. 21 East  
2670 Ft. from South Line of Section  
2620 Ft. from East Line of Section

(Note: Locate well on Section Plat on reverse side)  
Nearest lease or unit boundary line 30 feet  
County LINN

Lease Name WEBER C Well # W-1-0  
Ground surface elevation ..... feet MSL  
Domestic well within 330 feet:  yes  no  
Municipal well within one mile:  yes  no  
Depth to bottom of fresh water .....  
Depth to bottom of usable water 150  
Surface pipe by Alternate: 1  2   
Surface pipe planned to be set 20  
Conductor pipe required .....  
Projected Total Depth 800 feet  
Formation BORGESS

INS


20 10

Must be filed with the K.C.C. five (5) days prior to commencing well  
 This card void if drilling not started within six (6) months of date received by K.C.C.

**Important procedures to follow:**

1. Notify District office before setting surface casing.
2. Set surface casing by circulating cement to the top.
3. File completion forms ACO-1 with K.C.C. within 120 days of well spud date, following instructions on ACO-1, side 1, and including copies of wireline logs.
4. Notify District office 48 hours prior to old well workover or re-entry.
5. Prior to filing Intent, prepare a proposed plugging plan in case well is D & A, then obtain approval of plan when calling district office prior to setting surface pipe.
6. Submit plugging report (CP-4) to K.C.C. after plugging is completed.
7. Obtain an approved injection ticket number before disposing of salt water.
8. Notify K.C.C. within 10 days when injection commences or terminates.
9. If an alternate 2<sup>nd</sup> completion, cement in the production pipe from below any usable water to surface within 120 days of spud date.

**A Regular Section of Land  
 1 Mile = 5,280 Ft.**

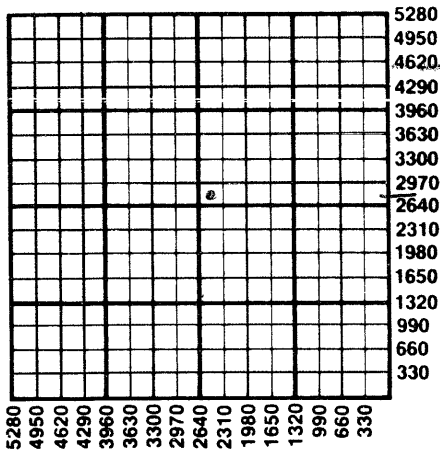

RECEIVED  
 STATE CORPORATION COMMISSION  
 OCT 8 1987  
 CONSERVATION DIVISION  
 Wichita, Kansas

10-8-87

State Corporation Commission of Kansas  
 Conservation Division  
 200 Colorado Derby Building  
 Wichita, Kansas 67202-1212  
 (316) 263-3238