

CARD MUST BE TYPED

State of Kansas
NOTICE OF INTENTION TO DRILL
(see rules on reverse side)

CARD MUST BE SIGNED

Starting Date: 4/26/85
month day year

API Number 15- 107-22,548-00-00

OPERATOR: License # 9817

SW/4 SW. Sec 13. Twp 22. S, Rge 21. East West
(location)

Name CLIFTON E. COOK

Address 22214 GREENBROOK

City/State/Zip HOUSTON, TEXAS 77073

Contact Person FRANK WEBER

Phone 9137562377

1730 Ft North from Southeast Corner of Section
4285 Ft West from Southeast Corner of Section
(Note: Locate well on Section Plat on reverse side)

CONTRACTOR: License # 6451

Name BIG E DRILLING

City/State ROUTE 1, CENTERVILLE KANSAS 66014

Nearest lease or unit boundary line 495 feet.

County LINN

Lease Name WEBER, B. Well# 9

Domestic well within 330 feet: yes no

Municipal well within one mile: yes no

Well Drilled For: Well Class: Type Equipment:

- Oil Swd Infield Mud Rotary
- Gas Inj Pool Ext. Air Rotary
- OWWO Expl Wildcat Cable

Depth to Bottom of fresh water feet

Lowest usable water formation feet

Depth to Bottom of usable water 150 feet

Surface pipe by Alternate: 1 2

Surface pipe to be set 20 feet

Conductor pipe if any required feet

Ground surface elevation feet MSL

This Authorization Expires 10-22-85

Approved By 4-22-85 [Signature]

If OWWO: old well info as follows:

Operator

Well Name

Comp Date Old Total Depth

Projected Total Depth 900ft feet

Projected Formation at TD MISSISSIPPI

Expected Producing Formations

I certify that we will comply with K.S.A. 55-101, et seq., plus eventually plugging hole to K.C.C. specifications.

Date 4/20/85 Signature of Operator or Agent

[Signature: Clifton E. Cook]

Title OWNER/OPERATOR

MHC/UDHE 4-22-85

Must be filed with the K.C.C. five (5) days prior to commencing well
This card void if drilling not started within six (6) months of date received by K.C.C.


RECEIVED
STATE CORPORATION COMMISSION

4-22-85

Important procedures to follow

APR 22 1985

A Regular Section of Land
1 Mile = 5,280 Ft.

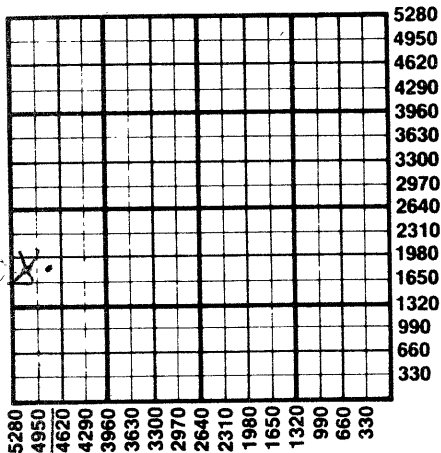

1. Notify District office before setting surface casing.
2. Set surface casing by circulating cement to the top.
3. File completion forms ACO-1 with K.C.C. within 90 days of well completion, following instructions on ACO-1, side 1, and including copies of wireline logs.
4. Notify District office 48 hours prior to old well workover or re-entry.
5. Prior to plugging, prepare a plugging plan, then obtain agreement from the appropriate district office for an approved plugging plan.
6. Submit plugging report (CP-4) to K.C.C. after plugging is completed.
7. Obtain an approved injection docket number before disposing of salt water.
8. Notify K.C.C. within 10 days when injection commences or terminates.
9. If an alternate 2 completion, cement in the production pipe from below any usable water to surface within 120 days of spud date.

State Corporation Commission of Kansas
Conservation Division
200 Colorado Derby Building
Wichita, Kansas 67202
(316) 263-3238