

CARD MUST BE TYPED

State of Kansas NOTICE OF INTENTION TO DRILL

(see rules on reverse side)

CARD MUST BE SIGNED

Starting Date: 4/26/85
month day year

API Number 15- 107-22,549-00-00

OPERATOR: License # 9817
Name CLIFTON E. COOK
Address 22214 GREENBROOK
City/State/Zip HOUSTON TEXAS 77073
Contact Person FRANK WEBER
Phone 913-756-2377

SW NW SW 13
(location) Sec 13 Twp 22. S, Rge 21. East West
1400 Ft North from Southeast Corner of Section
4785 Ft West from Southeast Corner of Section
(Note: Locate well on Section Plat on reverse side)

CONTRACTOR: License # 6451
Name BIG E. DRILLING
City/State ROUTE 1; CENTERVILLE KANSAS 66014

Nearest lease or unit boundary line 49.5 feet.
County LINN
Lease Name WEBER B Well# 10

Well Drilled For: Well Class: Type Equipment:
 Oil Swd Infield Mud Rotary
 Gas Inj Pool Ext. Air Rotary
 OWWO Expl Wildcat Cable

Domestic well within 330 feet: yes no
Municipal well within one mile: yes no

If OWWO: old well info as follows:
Operator
Well Name
Comp Date Old Total Depth
Projected Total Depth 900 ft. feet
Projected Formation at TD MISSISSIPPI
Expected Producing Formations

Depth to Bottom of fresh water 20 feet
Lowest usable water formation
Depth to Bottom of usable water 150 feet
Surface pipe by Alternate: 1 2
Surface pipe to be set 20 feet
Conductor pipe if any required feet
Ground surface elevation feet MSL
This Authorization Expires 10-22-85
Approved By 4-22-85 [Signature]

I certify that we will comply with K.S.A. 55-101, et seq., plus eventually plugging hole to K.C.C. specifications.

Date 4/20/85 Signature of Operator or Agent

[Signature: Clifton E. Cook]

OWNER/OPERATOR

WMC/UDHE 4-22-85

Must be filed with the K.C.C. five (5) days prior to commencing well
 This card void if drilling not started within six (6) months of date received by K.C.C.

RECEIVED
 STATE CORPORATION COMMISSION


4-22-85

APR 22 1985

Important procedures to follow:

CONSERVATION DIVISION
 Wichita, Kansas

**A Regular Section of Land
 1 Mile = 5,280 Ft.**

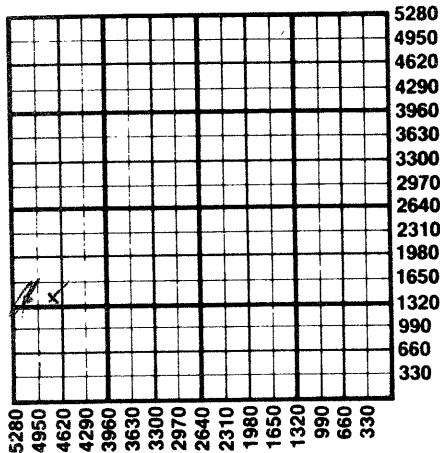

1. Notify District office before setting surface casing.
2. Set surface casing by circulating cement to the top.
3. File completion forms ACO-1 with K.C.C. within 90 days of well completion, following instructions on ACO-1, side 1, and including copies of wireline logs.
4. Notify District office 48 hours prior to old well workover or re-entry.
5. Prior to plugging, prepare a plugging plan, then obtain agreement from the appropriate district office for an approved plugging plan.
6. Submit plugging report (CP-4) to K.C.C. after plugging is completed.
7. Obtain an approved injection docket number before disposing of salt water.
8. Notify K.C.C. within 10 days when injection commences or terminates.
9. If an alternate 2 completion, cement in the production pipe from below any usable water to surface within 120 days of spud date.

**State Corporation Commission of Kansas
 Conservation Division
 200 Colorado Derby Building
 Wichita, Kansas 67202
 (316) 263-3238**