

15-141-00015-00-00

STATE OF KANSAS
STATE CORPORATION COMMISSION

WELL PLUGGING RECORD

Give All Information Completely
Make Required Affidavit
Mail or Deliver Report to:
Conservation Division
State Corporation Commission
211 No. Broadway
Wichita, Kansas

Osborne County. Sec. 27 Twp. 10S Rge. (E) 15 (W)

Location as "NE/CNW $\frac{1}{4}$ /SW $\frac{1}{4}$ " or footage from lines NE SE NW

Lease Owner John O. Farmer, Inc.

Lease Name GREEN Well No. 1

Office Address Russell, Kansas

Character of Well (completed as Oil, Gas or Dry Hole) Dry

Date well completed 7/11 19 58

Application for plugging filed 7/11 19 58

Application for plugging approved 7/11 19 58

Plugging commenced 7/11 19 58

Plugging completed 7/11 19 58

Reason for abandonment of well or producing formation Dry

If a producing well is abandoned, date of last production _____ 19 _____

Was permission obtained from the Conservation Division or its agents before plugging was commenced? yes

Name of Conservation Agent who supervised plugging of this well Don Truan, Gorham, Kansas

Producing formation _____ Depth to top _____ Bottom _____ Total Depth of Well 3341 Feet

Show depth and thickness of all water, oil and gas formations.

OIL, GAS OR WATER RECORDS

CASING RECORD

FORMATION	CONTENT	FROM	TO	SIZE	PUT IN	PULLED OUT
				8-5/8	180*	None

Describe in detail the manner in which the well was plugged, indicating where the mud fluid was placed and the method or methods used in introducing it into the hole. If cement or other plugs were used, state the character of same and depth placed, from _____ feet to _____ feet for each plug set.

First plug set at 180 feet with 25 sacks cement

Second plug set at 40 feet with 10 sacks cement

Received
7-24-58

(If additional description is necessary, use BACK of this sheet)

Name of Plugging Contractor John O. Farmer, Inc.

Address Russell, Kansas

STATE OF Kansas, COUNTY OF Russell, ss.

JOHN O. FARMER

(owner or operator) of the above-described

well, being first duly sworn on oath, says: That I have knowledge of the facts, statements, and matters herein contained and the log of the above-described well as filed and that the same are true and correct. So help me God.

(Signature)

John O. Farmer
Russell, Kansas
(Address)

SUBSCRIBED AND SWORN TO before me this 21st day of July, 19 58

My commission expires October 11, 1958

Lucille Kennedy
Lucille Kennedy
Notary Public.

PLUGGING
FILE SEC 27 T. 10 R. 15W
BOOK PAGE 116 LINE 5

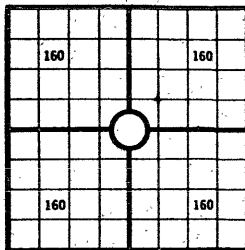
OPERATOR JOHN O. FARMER, INC.

15-141-00215-00-00

FORMATION RECORD

ADDRESS Russell, Kansas

Give detailed description and thickness of all formations drilled through, contents of sand, whether dry, water, oil or gas.

640 Acres
N

Locate well correctly

COUNTY Osborne SEC. 27 TWP. 10S RGE. 15WCOMPANY OPERATING John O. Farmer, Inc.OFFICE ADDRESS Russell, KansasFARM NAME GREEN WELL NO. 1DRILLING STARTED 7/2, 1958, DRILLING FINISHED 7/11, 1958

DATE OF FIRST PRODUCTION _____ COMPLETED _____

WELL LOCATED NE 1/4 SE 1/4 NW 1/4 North of South

Line and _____ ft. East of West Line of Quarter Section

Elevation (Relative to sea level) DERRICK FLOOR 1805 GROUND 1802CHARACTER OF WELL (Oil, gas or dryhole) Dry

OIL OR GAS SANDS OR ZONES

Name	From	To	Name	From	To
1			4		
2			5		
3			6		

Perforating Record If Any

Shot Record

Formation	From	To	No. of Shots	Formation	From	To	Size of Shot

CASING RECORD

Amount Set				Amount Pulled				Packer Record			
Size	Wt.	Thds.	Make	Ft.	In.	Ft.	In.	Size	Length	Depth Set	Make
8-5/8				180							

Liner Record: Amount _____ Kind _____ Top _____ Bottom _____

CEMENTING AND MUDDING

Size	Amount Set		Sacks Cement	Chemical		Method of Cementing	Amount	Mudding Method	Results (See Note)
	Ft.	In.		Gal.	Make				
8-5/8	180		125						

Note: What method was used to protect sands if outer strings were pulled? _____

NOTE: Were bottom hole plugs used? _____ If so, state kind, depth set and results obtained _____

TOOLS USED

Rotary Tools were used from _____ feet to _____ Cable tools were used from _____ feet to _____ feet, and from _____ feet to _____ feet, and from _____ feet to _____ feet to _____

Type Rig _____

INITIAL PRODUCTION TEST

Describe initial test: whether by flow through tubing or casing or by pumping _____

Amount of Oil Production _____ bbls. Size of choke, if any _____ Length of test _____ Water

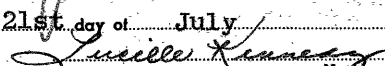
Production _____ bbls. Gravity of oil _____ Type of Pump if pump is used, describe _____

Formation	Top	Bottom	Formation	Top	Bottom
Shale & shells	0	220			
Shale, sand & shells	220	460			
Sand	460	515			
Shells & pyrite	515	525			
Shale & sand	525	598			
Sand	598	650			
Shale, shells & redbed	650	942	ELEVATION:	RB	1807
Anhydrite	942	974	Sample Tops:		
Shale, shells & redbed	974	1232	Topeka		2679
Shale & shells	1232	1485	Heebner		2924
Shale & lime	1485	2825	Toronto		2946
Lime & shale	2825	3110	Lansing		2973
Lime	3110	3160	Base Kansas City		3233
Lime & shale	3160	3326	Conglomerate		3320
Conglomerate	3326	3341	T.D.		3341
T.D.		3341	D & A		

FILE
 SEC. 27 T. 10 R. 15W
 BOOK PAGE 116 LINE 5
 PLUGGING

I, the undersigned, being first duly sworn upon oath, state that this well record is true, correct and complete according to the records of this office and to the best of my knowledge and belief.


 Name and title of representative of company

Subscribed and sworn to before me this 21st day of July, 1958
 My Commission expires 10/11/58

 Notary Public

GREEN
 WELL NO. 1 COUNTY Osborne SEC. 27 TWP. 10S., RGE. 15W.