


15-141-20048-00-00

STATE OF KANSAS
STATE CORPORATION COMMISSION

WELL PLUGGING RECORD

Give All Information Completely
Make Required Affidavit
Mail or Deliver Report to
Conservation Division
State Corporation Comm.
245 North Water
Wichita, KS 67202

Osborne County, Sec. 33 Twp. 10S Rge. 15W 1/4/W
Location as "NE/CNW 1/4 SW 1/4" or footage from lines
SE/4 SE/4 SW/4
Lease Owner W-W Oil Company
Lease Name Ross Well No. 1
Office Address Mr. Steve Ward, Natoma, Kansas 67651
Character of Well (Completed as Oil, Gas or Dry Hole) D & A
Date Well completed September 26, 1978
Application for plugging filed September 26, 1978
Application for plugging approved September 26, 1978
Plugging commenced September 26, 1978
Plugging completed September 26, 1978
Reason for abandonment of well or producing formation D & A

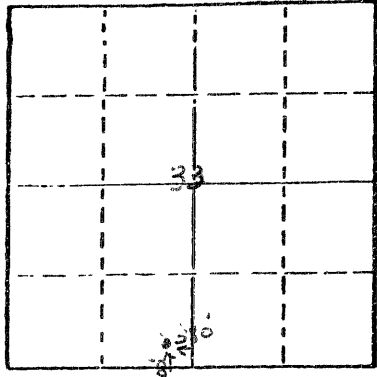

Locate well correctly on above Section Plat

If a producing well is abandoned, date of last production 19
Was permission obtained from the Conservation Division or its agents before plugging was commenced? Yes

Name of Conservation Agent who supervised plugging of this well Duane L. Rankin
Producing formation Depth to top Bottom Total Depth of Well 3,750'
Show depth and thickness of all water, oil and gas formations.

OIL, GAS OR WATER RECORDS

CASING RECORD

FORMATION	CONTENT	FROM	TO	SIZE	PUT IN	PULLED OUT
				8 5/8"	238.03'	-0-
					245.73'	
					KCL TAP	

Describe in detail the manner in which the well was plugged, indicating where the mud fluid was placed and the method or methods used in introducing it into the hold. If cement or other plugs were used, state the character of same and depth placed, from _____ feet to _____ feet for each plug set.

Hole plugged w/50 sx cement @ 540'
w/25 sx cement @ 240'
1/2 sx Hulls & plug @ 40' w/10 sx cement to surface
2 sx cement in rathole

Received
STATE CORPORATION COMMISSION
10-11-78
OCT 11 1978

(If additional description is necessary, use BACK of this sheet)

Name of Plugging Contractor Red Tiger Drilling Company & Allied Cementing

STATE OF Kansas COUNTY OF Sedgwick, ss. contractor
Gloria Fawcett (employee of ~~xxxxxx~~)
of the above-described well, being first duly sworn on oath, says: That I have knowledge of the facts, statements, and matters herein contained and the log of the above-described well as filed and that the same are true and correct. So help me God.

(Signature) Gloria Fawcett
1720 KSB&T Building, Wichita, Kansas 67202
(Address)

SUBSCRIBED AND SWORN TO before me this 2nd day of October, 1978.

My commission expires _____

Joyce A. Hagermann
Notary Public.



DRILLERS LOG

No. 1 Ross

CASING RECORD:	COMPANY:	W-W Oil Company	DESCRIPTION:
8 5/8" @ 245.73'	CONTRACTOR:	Red Tiger Drilling Company	SE/4 SE/4 SW/4
w/160 sx cement	COMMENCED:	September 15, 1978	Sec. 33-T10S-R15W
	COMPLETED:	September 26, 1978	Osborne County, Kansas
TOTAL DEPTH: 3,750'			ELEVATION: 2,032' KB

<u>FORMATION</u>	<u>FROM</u>	<u>TO</u>	<u>REMARKS</u>
Rock	0	20	
Shale	20	500	
Sand	500	570	
Sand & Shale	570	780	
Shale & Sand Streaks	780	890	
Red Bed	890	1217	
Anhydrite	1217	1256	
Shale	1256	1815	
Shale & Lime	1815	2167	
Lime & Shale	2167	2525	
Lime	2525	3750	
RTD		3750	

I certify that this is a true and correct copy of the above log to the best of my knowledge.

RED TIGER DRILLING COMPANY

Gloria Fawcett
Gloria Fawcett

Subscribed and sworn to before me this 2nd day of October, 1978.

Joyce A. Hagermann
Notary Public

