

15-141-00053-00-00

STATE OF KANSAS
STATE CORPORATION COMMISSION

Form CP-4


Give All Information Completely
Make Required Affidavit
Mail or Deliver Report to:
Conservation Division
State Corporation Commission
212 No. Market
Wichita, Kansas

WELL PLUGGING RECORD

Osborne County, Sec. 33 Twp. 10 Rge. 15W (SE) (W)

Location as "NE/CNW%SW%" or footage from lines NE SE SE
Lease Owner Rudy A. Herman Oil Operator
Lease Name Worley Well No. 1
Office Address Box 348 Russell, Kansas
Character of Well (completed as Oil, Gas or Dry Hole) oil-depleted
Date well completed 19____
Application for plugging filed 19____
Application for plugging approved 19____
Plugging commenced 19____
Plugging completed October 10, 19 59
Reason for abandonment of well or producing formation _____

NORTH

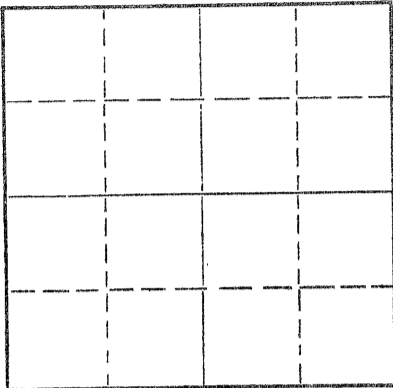

Locate well correctly on above
Section Plat

If a producing well is abandoned, date of last production 19____
Was permission obtained from the Conservation Division or its agents before plugging was commenced? yes

Name of Conservation Agent who supervised plugging of this well Donald Truan
Producing formation _____ Depth to top _____ Bottom _____ Total Depth of Well 3420 Feet
Show depth and thickness of all water, oil and gas formations.

OIL, GAS OR WATER RECORDS

CASING RECORD

| FORMATION | CONTENT | FROM | DATE | SIZE | PUT IN | PULLED OUT |
|-----------|---------|------|-----------------------|------|--------|------------|
| | | | 3-29-66 | | | |
| | | | MAR 29 1966 | | | |
| | | | CONSERVATION DIVISION | | | |
| | | | WICHITA, KANSAS | | | |

Describe in detail the manner in which the well was plugged, indicating where the mud fluid was placed and the method or methods used in introducing it into the hole. If cement or other plugs were used, state the character of same and depth placed, from _____ feet to _____ feet for each plug set.

Sand back to 3400' and 5 sacks cement with dump bailer, pulled pipe. Mud to 290', set rock bridge, and 25 sacks cement. Mud to 40', set rock bridge and 10 sacks cement, cementing to base of cellar.

(If additional description is necessary, use BACK of this sheet)
Name of Plugging Contractor Knight Casing Pulling Company
Address Chase, Kansas

STATE OF _____ COUNTY OF _____, ss.
_____, (employee of owner) or (owner or operator) of the above-described well, being first duly sworn on oath, says: That I have knowledge of the facts, statements, and matters herein contained and the log of the above-described well as filed and that the same are true and correct. So help me God.

(Signature) Rudy A. Herman

(Address)

SUBSCRIBED AND SWORN TO before me this 28th day of March, 1966

My commission expires

January 15, 1969

Shirley M. W. [Signature]

Notary Public.




Shields

Russell, Kansas

WELL LOG

Operator: Rudy A. Herman
 Well: Worley #1
 Commenced: March 30, 1959
 Completed: April 9, 1959
 Contractor: Shields Drilling Co., Inc.

Well Description: NE SE SE
 Sec. 33-10S-15W
 Osborne County, Kansas

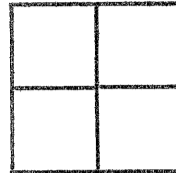

CASING RECORD

| Size | Run | Pulled |
|--------|-------|-----------------|
| 8 5/8" | 295' | Cmtd. w/180 sax |
| 5 1/2" | 3409' | Cmtd. w/75 sax |

Elevation: 1913' RB

Treatment:

Production:

Tops: Heebner 3015'
 Toronto 3039'
 Lansing-KC 3070'
 Cherty-Sandy Congl. 3408'

Figures Indicate Bottom of Formations

| | |
|------------------------------|-----------|
| Surface Soil, Shale & Shells | 175' |
| Shale & Shells | 350' |
| Sand | 450' |
| Sand & Shale | 710' |
| Red Bed | 1022' |
| Anhydrite | 1056' |
| Shale & Shells | 1400' |
| Shale & Salt | 1520' |
| Shale & Lime | 2691' |
| Lime | 3414' RTD |

Notes

DST #1 3075'-3150' Tool open 1 hr. w/fair blow thruout.
 Rec. 315' muddy water. BHP - 775#/30 min.

DST #2 3393'-3414' Tool open 1 hr. w/strong blow thruout.
 Rec. 511' clean oil, 248' muddy oil.
 BHP - 740#/30 min.

PLUGGING

File Sec. 33 T 10 R 15W

Book Page 4 Line 32

RECEIVED
 STATE CORPORATION COMMISSION
 9-28-59
 SEP 28 1959

CONSERVATION DIVISION
 Kansas