

CARD MUST BE SIGNED

XX East

..1760..... Ft West from Southeast Corner of Section
(Note: Locate well on Section Plat on reverse side)

Municipal well within one mile : ☐ yes ☒ no

Approved By.....6-25-25...../C.....

RC4 for KDF

Form C-1 4/84


Must be filed with the K.C.C. five (5) days prior to commencing well
 This card void if drilling not started within six (6) months of date received by K.C.C.
 CONSERVATION DIVISION

JUN 7 5 1985

6-25-85

Important procedures to follow:

RECEIVED
 STATE CORPORATION COMMISSION
 A Regular Section of Land
 1 Mile = 5,280 Ft.

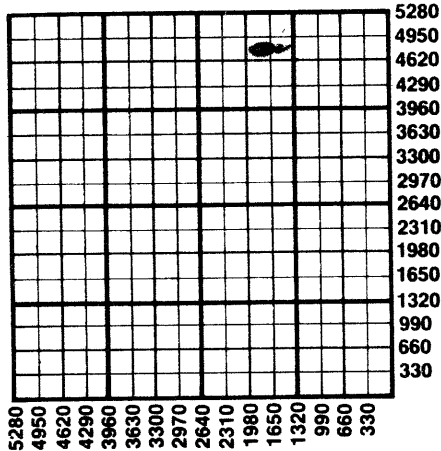

1. Notify District office before setting surface casing.
2. Set surface casing by circulating cement to the top.
3. File completion forms ACO-1 with K.C.C. within 90 days of well completion, following instructions on ACO-1, side 1, and including copies of wireline logs.
4. Notify District office 48 hours prior to old well workover or re-entry.
5. Prior to plugging, prepare a plugging plan, then obtain agreement from the appropriate district office for an approved plugging plan.
6. Submit plugging report (CP-4) to K.C.C. after plugging is completed.
7. Obtain an approved injection docket number before disposing of salt water.
8. Notify K.C.C. within 10 days when injection commences or terminates.
9. If an alternate 2 completion, cement in the production pipe from below any usable water to surface within 120 days of spud date.

State Corporation Commission of Kansas
 Conservation Division
 200 Colorado Derby Building
 Wichita, Kansas 67202
 (316) 263-3238