

CARD MUST BE TYPED

State of Kansas
NOTICE OF INTENTION TO DRILL
(see rules on reverse side)

CARD MUST BE SIGNED

Starting Date: July 24, 1985
month day year

API Number 15- 107-22, 671-0000

OPERATOR: License # 5756
Name Triple-I Energy Corporation
Address 6600 College Blvd. #310
City/State/Zip Overland Park, KS 66211
Contact Person Lila Highfill
Phone 913.345.8000

App. NE NE NE Sec 23 Twp 22 S, Rge 21 East
(location) West

4840 Ft North from Southeast Corner of Section
30 Ft West from Southeast Corner of Section
(Note: Locate well on Section Plat on reverse side)

CONTRACTOR: License # 7747
Name Western Exploration
City/State Littleton, Co

Nearest lease or unit boundary line 30 feet.
County Linn

Lease Name Ewing "A" Well# 42-W

Domestic well within 330 feet: yes no
Municipal well within one mile: yes no

Well Drilled For: Well Class: Type Equipment:
 Oil Swd Infield Mud Rotary
 Gas Inj Pool Ext. Air Rotary
 OWWO Expl Wildcat Cable

Depth to Bottom of fresh water 152 feet
Lowest usable water formation Chanute Shale
Depth to Bottom of usable water 150 feet
Surface pipe by Alternate: 1 2

If OWWO: old well info as follows:
Operator
Well Name
Comp Date Old Total Depth
Projected Total Depth 1000 feet
Projected Formation at TD
Expected Producing Formations

Surface pipe to be set 20 feet
Conductor pipe if any required feet
Ground surface elevation feet MSL
This Authorization Expires 1-23-86
Approved By RCH 7-23-85

I certify that we will comply with K.S.A. 55-101, et seq., plus eventually plugging hole to K.C.C. specifications.

Date 7/23/85 Signature of Operator or Agent LuAnne Cortina Title as agent

Must be filed with the K.C.C. five (5) days prior to commencing well
 This card void if drilling not started within six (6) months of date received by K.C.C.


RECEIVED
 STATE CORPORATION COMMISSION

7-23-85
 10/23/1985

Important procedures to follow:

1. Notify District office before setting surface casing. CONSERVATION DIVISION
Wichita, Kansas
2. Set surface casing by circulating cement to the top.
3. File completion forms ACO-1 with K.C.C. within 90 days of well completion, following instructions on ACO-1, side 1, and including copies of wireline logs.
4. Notify District office 48 hours prior to old well workover or re-entry.
5. Prior to plugging, prepare a plugging plan, then obtain agreement from the appropriate district office for an approved plugging plan.
6. Submit plugging report (CP-4) to K.C.C. after plugging is completed.
7. Obtain an approved injection docket number before disposing of salt water.
8. Notify K.C.C. within 10 days when injection commences or terminates.
9. If an alternate 2 completion, cement in the production pipe from below any usable water to surface within 120 days of spud date.

A Regular Section of Land
 1 Mile = 5,280 Ft.

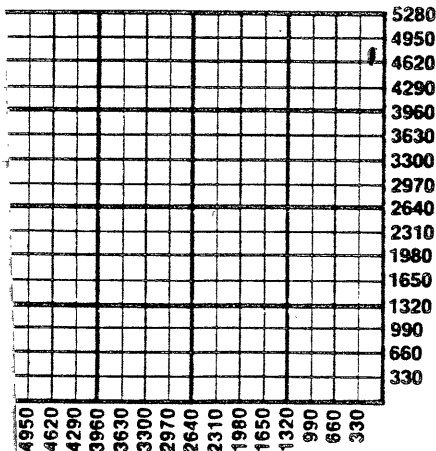

State Corporation Commission of Kansas
 Conservation Division
 200 Colorado Derby Building
 Wichita, Kansas 67202

(316) 263-2228