

CARD MUST BE TYPED

State of Kansas

CARD MUST BE SIGNED

NOTICE OF INTENTION TO DRILL

(see rules on reverse side)

Starting Date 9 12 85
month day year 3:15

API Number 15- 107-22,751-00-00

OPERATOR: License # 5756
Name Triple I Energy Corp.
Address 6600 College Blvd. # 310
City/State/Zip Overland Park, KS 66211
Contact Person Lila Highfill
Phone 913-345-8000

app. NE SE NE Sec. 23 Twp. 22 S, Rg. 21 East
3830
510 West

(Note: Locate well on Section Plat on reverse side)

CONTRACTOR: License #
Name Unknown
City/State

Nearest lease or unit boundary line 510 feet
County Linn
Lease Name Ewing Well # WS-1

Well Drilled For: Oil Gas OWWO
 SWD Inj Pool Ext. Expl
Well Class: Infield Wildcat
Type Equipment: Mud Rotary Air Rotary Cable

Ground surface elevation na feet MSL
Domestic well within 330 feet: yes no
Municipal well within one mile: yes no
Surface pipe by Alternate: 1 2

If OWWO: old well info as follows:
Operator
Well Name
Comp Date Old Total Depth

Depth to bottom of fresh water 152
Depth to bottom of usable water 152
Surface pipe planned to be set 20
Projected Total Depth 900 feet
Formation Mississippian

I certify that well will comply with K.S.A. 55-101, et seq., plus eventually plugging hole to KCC specifications.

_____ cementing will be done immediately upon setting production casing.
Date 9/11/85 Signature of Operator or Agent *Kanana J. Bingham* Title As Agent

Red Bank KAE

For KCC Use:
Conductor Pipe Required _____ feet; Minimum Surface Pipe Required _____ feet per Alt. 1 2
This Authorization Expires 3-11-86 Approved By *K* 9-11-85

Must be filed with the K.C.C. five (5) days prior to commencing well
This card void if drilling not started within six (6) months of date received by K.C.C.


9-11-85

RECEIVED
STATE CORPORATION COMMISSION

SEP 11 1985

A Regular Section of Land
1 Mile = 5,280 Ft.

CONSERVATION DIVISION
Wichita, Kansas

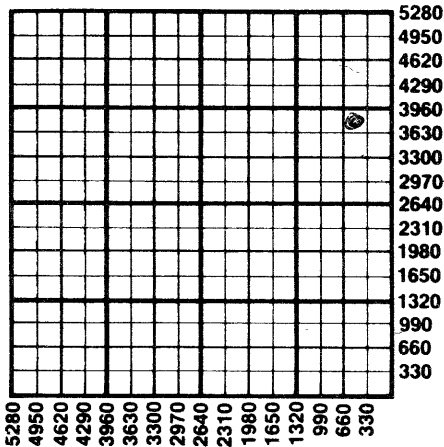

Important procedures to follow:

1. Notify District office before setting surface casing.
2. Set surface casing by circulating cement to the top.
- File completion forms ACO-1 with K.C.C. within 90 days of well completion, following instructions on ACO-1, side 1, and including copies of wireline logs.
4. Notify District office 48 hours prior to old well workover or re-entry.
5. Prior to filing Intent, prepare a proposed plugging plan in case well is D & A, then obtain approval of plan when calling district office prior to setting surface pipe.
6. Submit plugging report (CP-4) to K.C.C. after plugging is completed.
7. Obtain an approved injection docket number before disposing of salt water.
8. Notify K.C.C. within 10 days when injection commences or terminates.
9. If an alternate 2 completion, cement in the production pipe from below any usable water to surface within 120 days of spud date.

State Corporation Commission of Kansas
Conservation Division
200 Colorado Derby Building
Wichita, Kansas 67202
(316) 263-3238