

CARD MUST BE TYPED

State of Kansas

CARD MUST BE SIGNED

NOTICE OF INTENTION TO DRILL

(see rules on reverse side)

Starting Date September 22, 1986
month day year

API Number 15— 144-20,025-00-01
Approx. _____ East

OPERATOR: License # 6600

S/2 NW, NE... Sec. 27... Twp... 10. S, Rg... 15... West

Name Don. Karst. Well Service

..... 4380

Address 201 E. 9th

..... Ft. from South Line of Section

City/State/Zip Hays, KS. 67601

..... 2120

Contact Person Don. Karst.

Phone (913)-483-3958

(Note: Locate well on Section Plat on reverse side)

Nearest lease or unit boundary line 520 feet

County Osborne

CONTRACTOR: License # 8241

Lease Name Greene Well # 1

Name Emphasis Oil Operations

Ground surface elevation 1781 feet MSL

City/State P. O. Box 506, Russell, KS. 67665-0506

Domestic well within 330 feet: _____ yes no

Well Drilled For: Well Class: Type Equipment:

Municipal well within one mile: _____ yes no

Oil _____ SWD Infield Mud Rotary

Depth to bottom of fresh water 60

_____ Gas _____ Inj _____ Pool Ext. _____ Air Rotary

Depth to bottom of usable water 600

OWWO _____ Expl _____ Wildcat _____ Cable

Surface pipe by Alternate: _____ 1 _____ 2

If OWWO: old well info as follows:

Surface pipe ~~planned to~~ be set 181 previously set

Operator C-G Drilling Co. & H. Rosen

Conductor pipe required N/A

Well Name Greene #1

Projected Total Depth 3450 feet

Comp Date 9-23-74 Old Total Depth 3340'

Formation Arbuckle

I certify that well will comply with K.S.A. 55-101, et seq., plus eventually plugging hole to KCC specifications.

Production string will be immediately cemented from below usable water to surface.

Date 9-11-86 Signature of Operator or Agent *[Signature]* Title _____ Agent

For KCC Use:

Conductor Pipe Required feet; Minimum Surface Pipe Required feet per Alt. 1 ⁽²⁾


This Authorization Expires 3-12-87 Approved By 9-12-86 *[Signature]*

Must be filed with the K.C.C. five (5) days prior to commencing well
This card void if drilling not started within six (6) months of date received by K.C.C.

Important procedures to follow:

1. Notify District office before setting surface casing.
2. Set surface casing by circulating cement to the top.
3. File completion forms ACO-1 with K.C.C. within 90 days of well completion, following instructions on ACO-1, side 1, and including copies of wireline logs.
4. Notify District office 48 hours prior to old well workover or re-entry.
5. Prior to filing Intent, prepare a proposed plugging plan in case well is D & A, then obtain approval of plan when calling district office prior to setting surface pipe.
6. Submit plugging report (CP-4) to K.C.C. after plugging is completed.
7. Obtain an approved injection docket number before disposing of salt water.
8. Notify K.C.C. within 10 days when injection commences or terminates.
9. If an alternate 2 completion, cement in the production pipe from below any usable water to surface within 120 days of spud date.

**A Regular Section of Land
1 Mile = 5,280 Ft.**

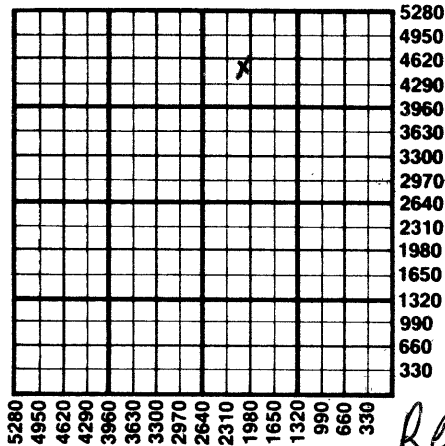

Received

9/10/86

SEP 12 1986

State Corporation Commission of Kansas
Conservation Division
200 Colorado Derby Building
Wichita, Kansas 67202
(316) 263-3238