

KANSAS CORPORATION COMMISSION  
OIL & GAS CONSERVATION DIVISION  
**WELL PLUGGING APPLICATION**  
Please TYPE Form and File ONE Copy

Form CP-1  
September 2003  
This Form must be Typed  
Form must be Signed  
All blanks must be Filled

API # 15 - 05102818 -00-00 (Identifier Number of this well). This must be listed for wells drilled since 1967; if no API # was issued,

indicate original spud or completion date \_\_\_\_\_.

Well Operator: Elysium Energy, LLC KCC License #: 32754

(Owner / Company Name)

(Operator's)

Address: 1016 East Highway 40 Bypass City: Hays

State: KS Zip Code: 67601 Contact Phone: ( 785 ) 625 - 5480

Lease: Sanders 'G' Well #: 4 Sec. 35 Twp. 13 S. R. 17  East  West

NE - NE - SW Spot Location / QQQQ County: Ellis

2310 Feet (in exact footage) From  North /  South (from nearest outside section corner) Line of Section (Not Lease Line)

2970 Feet (in exact footage) From  East /  West (from nearest outside section corner) Line of Section (Not Lease Line)

Check One:  Oil Well  Gas Well  D&A  Cathodic  Water Supply Well

SWD Docket # \_\_\_\_\_  ENHR Docket # \_\_\_\_\_  Other: \_\_\_\_\_

Conductor Casing Size: N/A Set at: \_\_\_\_\_ Cemented with: \_\_\_\_\_ Sacks

Surface Casing Size: 8 5/8" Set at: 182' Cemented with: 175 Sacks

Production Casing Size: 5 1/2" Set at: 3464 Cemented with: 150 Sacks

List (ALL) Perforations and Bridgeplug Sets: Lansing-Kansas City perforations 3,215'-3,390'; Arbuckle open-hole 3,464'-3,488'

Elevation: (  G.L. /  K.B. ) T.D.: 3,488' PBDT: \_\_\_\_\_ Anhydrite Depth: 1,119'

(Stone Corral Formation)

Condition of Well:  Good  Poor  Casing Leak  Junk in Hole

Proposed Method of Plugging (attach a separate page if additional space is needed): Procedure attached

Is Well Log attached to this application as required?  Yes  No Is ACO-1 filed?  Yes  No

If not explain why? \_\_\_\_\_

Plugging of this Well will be done in accordance with K.S.A. 55-101 et. seq. and the Rules and Regulations of the State Corporation Commission.

List Name of Company Representative authorized to be in charge of plugging operations: Mr. Dave Stahl

Phone: ( 785 ) 625 - 5480

Address: 1016 East Highway 40 Bypass City / State: Hays, KS

Plugging Contractor: Allied Cementing KCC License #: 99996

(Company Name)

(Contractor's)


Address: \_\_\_\_\_ Phone: ( ) -

Proposed Date and Hour of Plugging (if known?): Unknown

Payment of the Plugging Fee (K.A.R. 82-3-118) will be guaranteed by Operator or Agent

Date: 10/13/2006 Authorized Operator / Agent: \_\_\_\_\_ (Signature)

Mail to: KCC - Conservation Division, 130 S. Market - Room 2078, Wichita, Kansas 67202

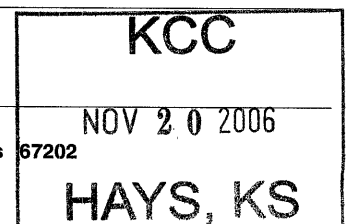

**SANDERS 'G' #4**  
NE NE SW SEC. 35-T13S-R17W  
Toulon Field, Ellis County, KS

**Plugging Procedure**

1. MIRU cementing company
2. RIH with open ending 2-7/8" work string
3. Cement well using 350 sks total cement (60/40 poz w/ 10%)
4. Pull tubing out of hole
5. Load and top off casing with cement.
6. Cut-off casing 4' below ground level
7. Remediate location
8. RDMO

RECEIVED  
NOV 22 2006  
KCC WICHITA



Central Kansas District

API # 1505102818

Spud Date: 05/07/1956  
Completed: 05/16/1956

Field: Toulon


GL: Unknown  
KB: 1949'

**Surface Casing :**  
8-5/8" 24# set @ 182'  
Cemented with 175 sx

**Production Casing:**  
5-1/2", 14# J-55 set @ 3464'  
Cemented with 150 sx

Packer @ 3444'

**Sanders G #4**  
NE NE SW Section 35-T13S-R17W  
Ellis County, Kansas  
Current Wellbore Schematic  
7/13/2006

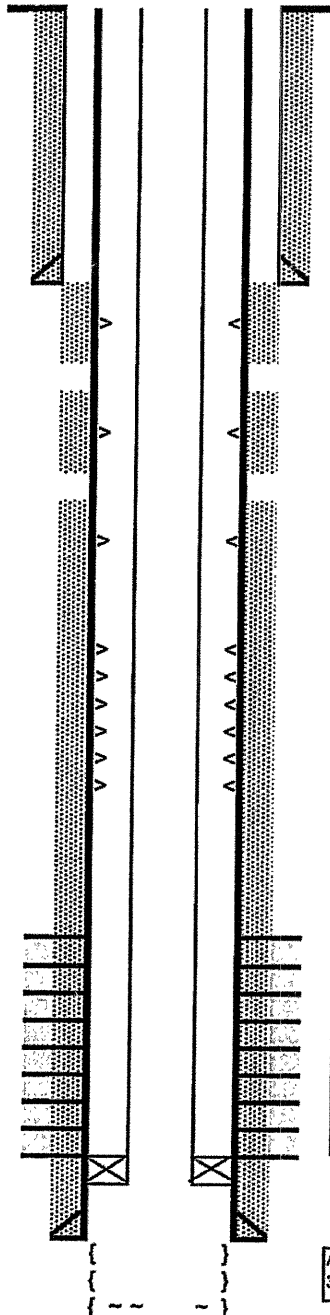

TOC Surface  
Circ.

Pumped 20 bbl. HCLM polymer 6/23/06

Sqz w/pkr @ 1171' 6/29/06  
w/150 sx w/2% CCI & 10% Cal-Seal

Csg. Leak @ 515'  
Sqzd w/225 sx 01/1959

Casing leak 512'-606' 6/8/06  
Sqzd w/150 sx 6/9/06  
Csg. Leak @ 787'  
Sqzd w/175 sx 01/1959

Csg. Leak @ 900'  
Sqzd w/150 sx 09/1979  
Sqzd holes 1375'-1485' w/150 sx 6/15/06  
Sqzd 1232'-1200' w/250 sx 6/2/06  
Sqz csg lk 1304'-1384' w/250 sx 6/19/06  
Casing leak below 1326'  
Casing leak 1304'-1384' 6/8/06  
Sqzd w/150 sx 6/9/06  
Casing leak @ 1827'-58'  
Sqzd w/ 140 sx 5/31/06  
Casing leaks 2760'-94' 5/30/2006  
Sqzd w/155 sx 5/31/06  
Sqzd w/100 sx 6/9/06

LKC Perfs:	
"A"	3215'-21' 11/1964
"B"	3239'-45' 11/1964
"B"	3240'-50' 11/1991
"D"	3258'-64' 11/1964
"G"	3284'-88' 11/1964
"G"	3297'-307' 11/1991
"H"	3372'-82' 11/1991
"H"	3380'-90' 11/1991

Arbuckle OH:  
3464'-88'

PBTD:  
TD: 3488'  
Deepened 06/1957

RECEIVED  
NOV 22  
KCC WICHITA

# KANSAS

CORPORATION COMMISSION

Kathleen Sebelius, Governor    Brian J. Moline, Chair    Robert E. Krehbiel, Commissioner    Michael C. Moffet, Commissioner

## NOTICE OF RECEIPT OF WELL PLUGGING APPLICATION (CP-1)

Elysium Energy, L.L.C.  
1625 Broadway, Ste 2000  
Denver, CO 80202

December 04, 2006

Re: SANDERS G #4  
API 15-051-02818-00-00  
NENESW 35-13S-17W, 2310 FSL 2310 FWL  
ELLIS COUNTY, KANSAS

Dear Operator:

This letter is to notify you that the Conservation Division is in receipt of your plugging proposal, form CP-1, for the above-captioned well.

Your CP-1 has been reviewed by the Conservation Division central office for completeness and to verify license numbers. The plugging proposal will now be forwarded to the district office listed below for review of your proposed method of plugging.

**Please contact the district office for approval of your proposed plugging method at least five (5) days before plugging the well, pursuant to K.A.R. 82-3-113 (b). If a workover pit will be used during the plugging of the well it must be permitted. A CDP-1 form must be filed and approved prior to the use of the pit.**

The Conservation Division's review of form CP-1, either in the central or district office, does not include an inquiry into well ownership or the filing operator's legal right to plug the well.

**This notice in no way constitutes authorization to plug the above-captioned well by persons not having legal rights of ownership or interest in the well. This notice is void after ninety (90) days from the above date.**

Sincerely



Barry Metz  
Deputy Director

District: #4  
2301 E. 13th  
Hays, KS 67601  
(785) 625-0550