


STATE OF KANSAS
STATE CORPORATION COMMISSION

WELL PLUGGING RECORD

Give All Information Completely
Make Required Affidavit
Mail or Deliver Report to
Conservation Division
State Corporation Comm.
245 North Water
Wichita, KS 67202

Rooks _____ County. Sec. 29 Twp. 9S Rge. 17 E/W
Location as "NE/CNW $\frac{1}{4}$ SW $\frac{1}{4}$ " or footage from lines _____

NE NW SW
Lease Owner Woodman-Iannitti Drilling Co.
Lease Name Eads "B" Well No. 1
Office Address 1008 Douglas Bldg., Wichita, KS. 67202
Character of Well (Completed as Oil, Gas or Dry Hole) _____

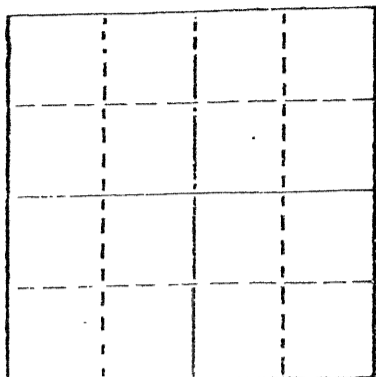

Locate well correctly on above
Section Plat

Dry Hole
Date Well completed _____ 12-10 1981
Application for plugging filed _____ 12-10 1981
Application for plugging approved _____ 12-10 1981
Plugging commenced _____ 12-10 1981
Plugging completed _____ 12-10 1981

Reason for abandonment of well or producing formation _____
Commercial quantities of oil not found
If a producing well is abandoned, date of last production _____
19

Was permission obtained from the Conservation Division or
its agents before plugging was commenced? Yes

Name of Conservation Agent who supervised plugging of this well Marion Schmidt
Producing formation _____ Depth to top _____ Bottom _____ Total Depth of Well 3684'
Show depth and thickness of all water, oil and gas formations.

OIL, GAS OR WATER RECORDS

CASING RECORD

FORMATION	CONTENT	FROM	TO	SIZE	PUT IN	PULLED OUT
				8 5/8"	253'	none

Describe in detail the manner in which the well was plugged, indicating where the mud fluid
was placed and the method or methods used in introducing it into the hold. If cement or other
plugs were used, state the character of same and depth placed, from _____ feet to
_____ feet for each plug set.

- Plug @ 840' w/70 sx.
- Plug @ 250' w/40 sx.
- Plug @ 40' w/10 sx.
- Rat Hole w/10 sx.

(If additional description is necessary, use BACK of this sheet)

Name of Plugging Contractor Buffalo Drilling Company, Inc.

STATE OF Kansas COUNTY OF Sedgwick, ss.

Jerald W. Rains, President of Buffalo Drilling Company, (Employee of owner) or (owner or operator)
of the above-described well, being first duly sworn on oath, says: That I have knowledge of
the facts, statements, and matters herein contained and the log of the above-described well
as filed and that the same are true and correct. So help me God.

(Signature) Jerald W. Rains
435 Page Court, 220 W. Douglas Wichita, KS
(Address) 67202

SUBSCRIBED AND SWORN TO before me this 14th day of December, 1981.



Juanita M. Green
Notary Public.

My commission expires 10-4-83

12-16-81
CONSERVATION DIVISION
Wichita, Kansas