

STATE OF KANSAS  
STATE CORPORATION COMMISSION

Give All Information Completely  
Make Required Affidavit  
Mail or Deliver Report to  
Conservation Division  
State Corporation Comm.  
200 Colorado Derby Bldg.  
202 W. 1st St.  
Wichita, KS 67202

WELL PLUGGING RECORD

Osborne County Sec. 20 Twp. 10 Rge. 15 E/W  
Location as "NE/CNW/SW" or footage from lines  
SE NW SW

Lease Owner Liberty Enterprises Inc.

Lease Name Locke Well No. #1

Office Address 308 W. Mill Plainville, Kansas 67663

Character of Well (Completed as Oil, Gas or Dry Hole)  
Dry Hole

Date Well completed 4-15 19 83

Application for plugging filed 4-15 19 83

Application for plugging approved 4-15 19 83

Plugging commenced 8:00 PM 4-15- 19 83

Plugging completed 10:15 PM 4-15 19 83

Reason for abandonment of well or producing formation  
No Commercial Production


If a producing well is abandoned, date of last production  
19

Was permission obtained from the Conservation Division or  
its agents before plugging was commenced? Yes

Name of Conservation Agent who supervised plugging of this well Duane L. Rankin

Producing formation Depth to top Bottom Tl. Depth of Well

Show depth and thickness of all water, oil and gas formations.

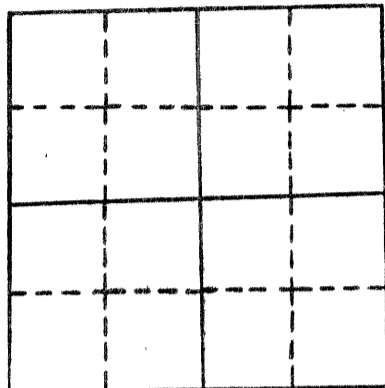

locate well correctly  
on above  
Section Plot

OIL, GAS OR WATER RECORDS

CASING RECORD

FORMATION	CONTENT	FROM	TO	SIZE	PUT IN	PULLED OUT
surface casing	common	0'	204'	8 5/8"	204'	0'

Describe in detail the manner in which the well was plugged, indicating where the mud fluid was placed and the method or methods used in introducing it into the hold. If cement or other plugs were used, state the character of same and depth placed, from feet to feet for each plug set.

Plug #1 1253' with 20 sxs

Plug #2 753' with 80 sxs

Plug #3 250' with 40 sxs

Plug #4 40' with 10 sxs

10 sxs in rathole

TOTAL----- 160 sxs 50-50 pos 4%gel 3%cc


P.D. @ 10:15 PM 4-15-83

(If additional description is necessary, use BACK of this sheet)

Name of Plugging Contractor Pioneer Drilling Co.  
308 W. Mill Plainville, Kansas 67663

STATE OF Kansas COUNTY OF Rooks, ss.

David L. Comeau (employee of owner) or (owner or operator) of the above described well, being first duly sworn on oath, says: That I have knowledge of the facts, statements, and matters herein contained and the log of the above described well is filed and that the same are true and correct. So help me God.

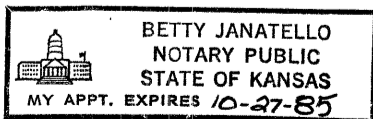

APR 27 1983 (Signature) David L. Comeau

CONSERVATION DIVISION (Address) 308 W. Mill Plainville, Ks. 67663  
Wichita, Kansas

SUBSCRIBED AND SWORN TO before me this 25th day of April, 1983

My commission expires 10-27-85

Betty Janatello  
Notary Public