


STATE OF KANSAS  
STATE CORPORATION COMMISSION

Give All Information Completely  
Make Required Affidavit  
Mail or Deliver Report to:  
Conservation Division  
State Corporation Commission  
212 North Market, Insurance Bldg.  
Wichita, Kansas

WELL PLUGGING RECORD

Rocks \_\_\_\_\_ County. Sec. 30 Twp. 25 Rge. 17W (E) \_\_\_\_\_ (W) \_\_\_\_\_  
Location as "NE/CNW/SW" or footage from lines C SW SW  
Lease Owner Davis Bros.  
Lease Name Osborne #1 Well No. 1  
Office Address 14 East Third St., Tulsa, Oklahoma  
Character of Well (completed as Oil, Gas or Dry Hole) Dry hole  
Date well completed March 14 19 61  
Application for plugging filed March 14 19 61  
Application for plugging approved March 14 19 61  
Plugging commenced March 14 19 61  
Plugging completed March 14 19 61  
Reason for abandonment of well or producing formation No production

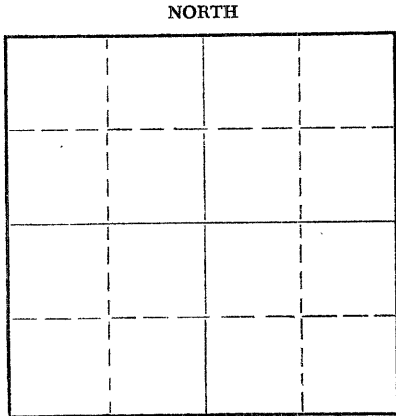

Locate well correctly on above  
Section Plat

If a producing well is abandoned, date of last production \_\_\_\_\_ 19 \_\_\_\_\_  
Was permission obtained from the Conservation Division or its agents before plugging was commenced? Yes

Name of Conservation Agent who supervised plugging of this well Eldon Petty, Box 326, Hays, Kansas  
Producing formation \_\_\_\_\_ Depth to top \_\_\_\_\_ Bottom \_\_\_\_\_ Total Depth of Well \_\_\_\_\_ Feet  
Show depth and thickness of all water, oil and gas formations.

OIL, GAS OR WATER RECORDS

CASING RECORD

FORMATION	CONTENT	FROM	TO	SIZE	PUT IN	PULLED OUT
				8 5/8"	210'	None

Describe in detail the manner in which the well was plugged, indicating where the mud fluid was placed and the method or methods used in introducing it into the hole. If cement or other plugs were used, state the character of same and depth placed, from \_\_\_\_\_ feet to \_\_\_\_\_ feet for each plug set.

~~Filled hole with heavy drilling mud to 480', set plug, cemented with 20 sacks of cement~~  
~~Filled hole with heavy drilling mud to 180', set plug, cemented with 20 sacks of cement~~  
~~filled hole with heavy drilling mud to 40', set plug, cemented with 10 sacks of cement~~  
~~to bottom of cellar~~

RECEIVED  
STATE CORPORATION COMMISSION

APR 10 1961  
4-10-61  
CONSERVATION DIVISION  
Wichita, Kansas

(If additional description is necessary, use BACK of this sheet)

Name of Plugging Contractor Transit Corporation  
Address 1516 Liberty Bank Bldg., Oklahoma City, Oklahoma

STATE OF Oklahoma, COUNTY OF Oklahoma, ss.  
Paul E. Gathers (employee of owner) of the above-described well, being first duly sworn on oath, says: That I have knowledge of the facts, statements, and matters herein contained and the log of the above-described well as filed and that the same are true and correct. So help me God.

(Signature) Paul E. Gathers

(Address)

SUBSCRIBED AND SWORN TO before me this 3rd day of April, 1961

Helen M. Anderson

My commission expires March 10, 1965

Notary Public.



STATE OF KANSAS  
STATE CORPORATION COMMISSION

Give All Information Completely  
Make Required Affidavit  
Mail or Deliver Report to:  
Conservation Division  
State Corporation Commission  
212 North Market, Insurance Bldg.  
Wichita, Kansas

WELL PLUGGING RECORD

Rooks County, Sec. 30 Twp. 9S Rge. 17W (E) (W)

Location as "NE/CNW/SW" or footage from lines C SW SW

Lease Owner Davis Bros.

Lease Name Osborne "C" Well No. 1

Office Address 14 East Third St., Tulsa, Oklahoma

Character of Well (completed as Oil, Gas or Dry Hole) Dry hole

Date well completed March 11, 19 61

Application for plugging filed March 11, 19 61

Application for plugging approved March 11, 19 61


Plugging commenced March 11, 19 61

Plugging completed March 11, 19 61

Reason for abandonment of well or producing formation No production

If a producing well is abandoned, date of last production 19

Was permission obtained from the Conservation Division or its agents before plugging was commenced? Yes

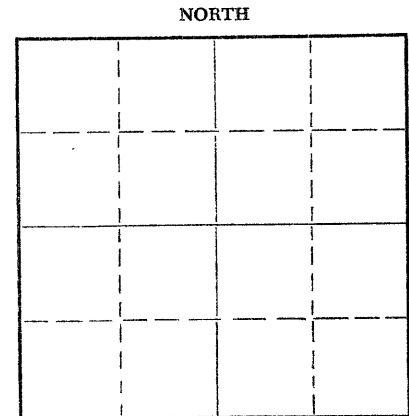

Locate well correctly on above Section Plat

Name of Conservation Agent who supervised plugging of this well Eldon Petty, Box 326, Hays, Kansas

Producing formation Depth to top Bottom Total Depth of Well Feet

Show depth and thickness of all water, oil and gas formations.

OIL, GAS OR WATER RECORDS

CASING RECORD

FORMATION	CONTENT	FROM	TO	SIZE	PUT IN	PULLED OUT
				8 5/8"	210'	None

Describe in detail the manner in which the well was plugged, indicating where the mud fluid was placed and the method or methods used in introducing it into the hole. If cement or other plugs were used, state the character of same and depth placed, from feet to feet for each plug set.

Filled hole with heavy drilling mud to 480', set plug, cemented with 20 sacks of cement  
Filled hole with heavy drilling mud to 180', set plug, cemented with 20 sacks of cement  
filled hole with heavy drilling mud to 40', set plug, cemented with 10 sacks of cement to bottom of cellar

RECEIVED  
STATE CORPORATION COMMISSION  
APR 11 1961  
4-11-61  
CONSERVATION DIVISION  
WICHITA, KANSAS

(If additional description is necessary, use BACK of this sheet)

Name of Plugging Contractor Transit Corporation

Address 1516 Liberty Bank Bldg., Oklahoma City, Oklahoma

STATE OF Oklahoma, COUNTY OF Oklahoma, ss.

Paul E. Gathers (employee of owner) or (owner or operator) of the above-described

well, being first duly sworn on oath, says: That I have knowledge of the facts, statements, and matters herein contained and the log of the above-described well as filed and that the same are true and correct. So help me God.

(Signature) Paul E. Gathers

(Address)

SUBSCRIBED AND SWORN TO before me this 3rd day of April, 19 61

Eldon M. Anderson

Notary Public.

My commission expires March 10, 1965



DRILLER'S WELL LOG

Davis Bros.

Osborne "C" # 1 well located in  
C SW SW, Section 30-98-17W-  
Rooks County, Kansas

Commenced: March 3, 1961  
Completed: March 14, 1961  
Elevation: 2117 R.B.

Casing : 8 5/8" @ 210'  
Cemented: w/125 sacks

<u>Formation</u>	<u>From</u>	<u>To</u>	<u>Summary of Formation</u>	
Surface clay	0	32	Topeka	3052'
Sand	32	38	Heebner	3266'
Shale	38	110	Toronto	3286'
Sand	110	135	Lansing	3308'
Shale	135	211	Base of Kansas City	3534'
Shale and shells	211	630	Conglomerate	3539'
Sand	630	735	Simpson	3570'
Shale and shells	735	750	Dolomite	3578'
Sand	750	905	Arbuckle	3624'
Shale	905	960		
Sand	960	1070		
Shale and red bed	1070	1385		
Shale	1385	1420		
Anhydrite	1420	1459		
Shale	1459	1800		
Lime and shale	1800	2165		
Lime	2165	2340		
Lime and shale	2340	2979		
Hard lime	2979	3075		
Lime and shale	3075	3228		
Lime	3228	3538		
Conglomerate and chert	3538	3584		
Conglomerate and Simpson	3584	3624		
Arbuckle	3624	3636 TD		

RECEIVED  
STATE CORPORATION COMMISSION

APR 10 1961  
4-10-61  
CONSERVATION DIVISION  
Wichita, Kansas

I hereby certify the foregoing to be a true and accurate Driller's Log  
of the formation encountered in the above well.

Subscribed and sworn to before me,  
This 3rd of April, 1961

TRANSIT CORPORATION

BY Paul E. Gubers

My commission expires 3-10-65

Stelan M. Anderson  
Notary Public

## DRILLER'S WELL LOG

Davis Bros.

Osborne "C" # 1 well located in  
C SW SW, Section 30-9S-17W-  
Rooks County, KansasCommenced: March 3, 1961  
Completed: March 14, 1961  
Elevation: 2117 R.B.Casing : 8 5/8" @ 210'  
Cemented: w/125 sacks

<u>Formation</u>	<u>From</u>	<u>To</u>	<u>Summary of Formation</u>	
Surface clay	0	32	Topeka	3052'
Sand	32	38	Heebner	3266'
Shale	38	110	Toronto	3286'
Sand	110	135	Lansing	3308'
Shale	135	211	Base of Kansas City	3534'
Shale and shells	211	630	Conglomerate	3539'
Sand	630	735	Simpson	3570'
Shale and shells	735	750	Dolomite	3578'
Sand	750	905	Arbuckle	3624'
Shale	905	960		
Sand	960	1070		
Shale and red bed	1070	1385		
Shale	1385	1420		
Anhydrite	1420	1459		
Shale	1459	1800		
Lime and shale	1800	2165		
Lime	2165	2340		
Lime and shale	2340	2979		
Hard lime	2979	3075		
Lime and shale	3075	3228		
Lime	3228	3538		
Conglomerate and chert	3538	3584		
Conglomerate and Simpson	3584	3624		
Arbuckle	3624	3636 TD		

**RECEIVED**  
STATE CORPORATION COMMISSION  
APR 11 1961  
4-11-61  
CONSERVATION DIVISION  
Wichita, Kansas

I hereby certify the foregoing to be a true and accurate Driller's Log of the formation encountered in the above well.

Subscribed and sworn to before me,  
This 3rd of April, 1961

TRANSIT CORPORATION

By Paul E. Gaden

My commission expires 3-10-65

Helen M. Anderson  
Notary Public