


STATE OF KANSAS
STATE CORPORATION COMMISSION

WELL PLUGGING RECORD

Give All Information Completely
Make Required Affidavit
Mail or Deliver Report to:
Conservation Division
State Corporation Commission
800 Bitting Building
Wichita, Kansas

Rooks County. Sec. 30 Twp. 9S Rge. (E) 17 (W)
Location as "NE/CNW $\frac{1}{4}$ SW $\frac{1}{4}$ " or footage from lines NE NE SE
Lease Owner Jones, Shelburne & Farmer, Inc.
Lease Name Adams Well No. 1
Office Address Russell, Kansas
Character of Well (completed as Oil, Gas or Dry Hole) Dry
Date well completed 9-8 19 52
Application for plugging filed 9-8 19 52
Application for plugging approved 9-8 19 52
Plugging commenced 9-8 19 52
Plugging completed 9-8-9 19 52
Reason for abandonment of well or producing formation Dry KCC NR

NORTH

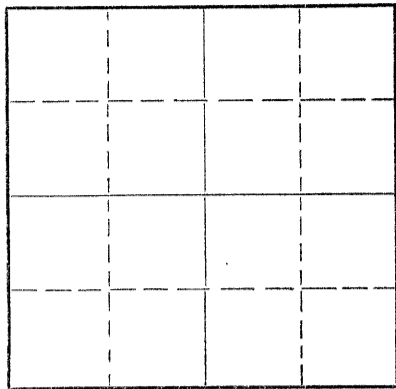

Locate well correctly on above
Section Plat

If a producing well is abandoned, date of last production Never Produced 19
Was permission obtained from the Conservation Division or its agents before plugging was commenced? Yes

Name of Conservation Agent who supervised plugging of this well Elden Petty
Producing formation Depth to top Bottom Total Depth of Well 3668 Feet
Show depth and thickness of all water, oil and gas formations.


OIL, GAS OR WATER RECORDS

CASING RECORD

FORMATION	CONTENT	FROM	TO	SIZE	PUT IN	PULLED OUT
				8 5/8	164'	None

Describe in detail the manner in which the well was plugged, indicating where the mud fluid was placed and the method or methods used in introducing it into the hole. If cement or other plugs were used, state the character of same and depth placed, from feet to feet for each plug set.

1. Filled hole with heavy mud
2. Pushed plug to 160'
3. Dumped 1/2 sack hulls on top of plug.
4. Mixed 15 sacks cement and dumped on top of hulls.
5. Filled hole to top
6. Pushed plug to 40'
7. Dumped in 1/2 sack hulls.
8. Mixed 10 sacks cement and filled hole to top with same.

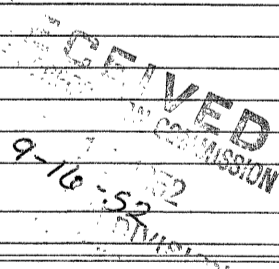

(If additional description is necessary, use BACK of this sheet)
Name of Plugging Contractor Jones, Shelburne & Farmer, Inc.
Address Russell, Kansas

STATE OF , COUNTY OF , ss. (employee of owner) or (owner or operator) of the above-described well, being first duly sworn on oath, says: That I have knowledge of the facts, statements, and matters herein contained and the log of the above-described well as filed and that the same are true and correct. So help me God.

(Signature) John W. Farmer
(Address)

SUBSCRIBED AND SWORN TO before me this 15th day of September, 19 52

My commission expires April 23, 1956
Donnie Berryhill Notary Public.

