


STATE OF KANSAS  
STATE CORPORATION COMMISSION

WELL PLUGGING RECORD

Give All Information Completely  
Make Required Affidavit  
Mail or Deliver Report to  
Conservation Division  
State Corporation Comm.  
245 North Water  
Wichita, KS 67202

Osborne County, Sec. 20 Twp. 10S Rge. 15W #/W  
Location as "NE/CNW 1/4 SW 1/4" or footage from lines  
1065' FSL & 255' FWL NW/4

Lease Owner Graham-Michaelis Corporation  
Lease Name Beck Well No. 1-20  
Office Address 211 North Broadway, Wichita, Kansas 67202  
Character of Well (Completed as Oil, Gas or Dry Hole) \_\_\_\_\_  
D & A

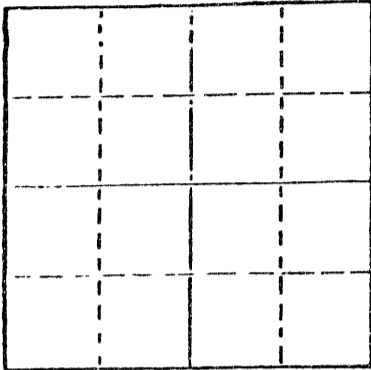

Locate well correctly on above  
Section Plat

Date Well completed July 9, 1978  
Application for plugging filed July 9, 1978  
Application for plugging approved July 9, 1978  
Plugging commenced July 10, 1978  
Plugging completed July 10, 1978  
Reason for abandonment of well or producing formation \_\_\_\_\_  
D & A

If a producing well is abandoned, date of last production  
19 \_\_\_\_\_

Was permission obtained from the Conservation Division or  
its agents before plugging was commenced? Yes

Name of Conservation Agent who supervised plugging of this well Duane L. Rankin  
Producing formation \_\_\_\_\_ Depth to top \_\_\_\_\_ Bottom \_\_\_\_\_ Total Depth of Well 3,600'  
Show depth and thickness of all water, oil and gas formations.

OIL, GAS OR WATER RECORDS

CASING RECORD

FORMATION	CONTENT	FROM	TO	SIZE	PUT IN	PULLED OUT
				8 5/8"	269.27'	-0-

Describe in detail the manner in which the well was plugged, indicating where the mud fluid  
was placed and the method or methods used in introducing it into the hold. If cement or other  
plugs were used, state the character of same and depth placed, from \_\_\_\_\_ feet to  
\_\_\_\_\_ feet for each plug set.

1st plug @ 540' w/50 sx cement  
2nd plug @ 240' w/25 sx cement  
3rd plug @ 40' w/1/2 sx hulls & 10 sx cement  
2 sx cement in rathole  
(Cement was 50/50 Pozmix, 4% Gel)

RECEIVED  
STATE CORPORATION COMMISSION  
JUL 20 1978  
7-20-78  
CONSERVATION DIVISION  
Wichita, Kansas

(If additional description is necessary, use BACK of this sheet)

Name of Plugging Contractor Red Tiger Drilling Company  
1720 KSB&T Building, Wichita, Kansas 67202


STATE OF Kansas COUNTY OF Sedgwick, ss. contractor  
Gloria Fawcett (employee of ~~xxxxxxx~~)  
of the above-described well, being first duly sworn on oath, says: That I have knowledge of  
the facts, statements, and matters herein contained and the log of the above-described well  
as filed and that the same are true and correct. So help me God.

(Signature) Gloria Fawcett  
1720 KSB&T Building, Wichita, Kansas 67202  
(Address)

SUBSCRIBED AND SWORN TO before me this 17th day of July, 1978.

My commission expires \_\_\_\_\_

Joyce A. Hagermann  
Notary Public.

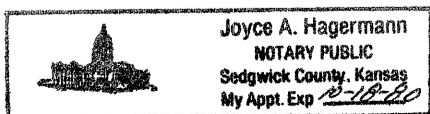

DRILLERS LOG

No. 1-20 Beck

CASING RECORD: 8 5/8" @ 277.44' w/175 sx cement  
 COMPANY: Graham-Michaelis Corporation  
 CONTRACTOR: Red Tiger Drilling Company  
 COMMENCED: June 28, 1978  
 COMPLETED: July 10, 1978 <sup>9, NR KCC</sup>  
 DESCRIPTION: 1065' FSL & 255' FWL NW/4 Sec. 20-T10S-R15W  
 TOTAL DEPTH: 3,600'  
 ELEVATION: 1,957' KB

<u>FORMATION</u>	<u>FROM</u>	<u>TO</u>	<u>REMARKS</u>
Surface Clay & Rock	0	68	
Shale	68	560	
Sand	560	655	
Hard Sand	655	660	
Shale	660	680	
Hard Sand & Sand	680	714	
Sand & Shale	714	814	
Shale	814	1143	
Anhydrite	1143	1185	
Shale	1185	1710	
Shale & Lime	1710	2130	
Lime & Shale	2130	3062	
Lime	3062	3533	
Conglomerate	3533	3600	
RTD		3600	

I certify that this is a true and correct copy of the above log to the best of my knowledge.

RECEIVED  
 STATE COMMISSION

JUL 20 1978  
 7-20-78  
 CONSERVATION DIVISION  
 Wichita, Kansas

RED TIGER DRILLING COMPANY

*Gloria Fawcett*  
 Gloria Fawcett

Subscribed and sworn to before me this 17th day of July, 1978.

*Joyce A. Hagermann*  
 Notary Public

