

CARD MUST BE TYPED

State of Kansas

CARD MUST BE SIGNED

### NOTICE OF INTENTION TO DRILL

(see rules on reverse side)

Expected Spud Date..... 11 month 5 day 87 year

API Number 15— 141-20237-00-00

OPERATOR: License # 5463  
Name ..... Samson Resources Company  
Address ..... Two West Second Street  
City/State/Zip Tulsa, OK 74103  
Contact Person. Charles Watkins  
Phone ..... 918/583-1791

SW. SW. NE. Sec. 22 Twp. 10 S, Rg. 15 East  West  
2970 Ft. from South Line of Section  
2310 Ft. from East Line of Section

(Note: Locate well on Section Plat on reverse side)

CONTRACTOR: License # 5420  
Name ..... White & Ellis Drilling  
City/State... Wichita, KS

Nearest lease or unit boundary line .. 330 feet  
County. Osborne

Lease Name... Koelling Well # 2  
Ground surface elevation .. 1790 feet MSL

Well Drilled For: Well Class: Type Equipment:  
 Oil  Storage  Infield  Mud Rotary  
 Gas  Inj.  Pool Ext.  Air Rotary  
 OWWO  Expl  Wildcat  Cable

Domestic well within 330 feet:  yes  no  
Municipal well within one mile:  yes  no

Depth to bottom of fresh water... 150  
Depth to bottom of usable water .. 1000 630

If OWWO: old well info as follows:

Surface pipe by Alternate:  1  2  X  
Surface pipe planned to be set .. 650

Operator .....  
Well Name .....  
Comp Date..... Old Total Depth.....

Conductor pipe required ..... None  
Projected Total Depth .. 3500 feet  
Formation... Lansing

I certify that well will comply with K.S.A. 55-101, et seq., plus eventually plugging hole to KCC specifications.

Date .. 10-28-87 Signature of Operator or Agent Charles Watkins Title.. Dr.lg. Supt.

For KCC Use:

Conductor Pipe Required ..... feet; Minimum Surface Pipe Required ..... 650 feet per Alt.   
This Authorization Expires 11-30-88 Approved By QA 10-30-87


11-4-87

Must be filed with the K.C.C. five (5) days prior to commencing well  
This card void if drilling not started within six (6) months of date received by K.C.C.

### Important procedures to follow:

1. Notify District office before setting surface casing.
2. Set surface casing by circulating cement to the top.
3. File completion forms ACO-1 with K.C.C. within 120 days of well spud date, following instructions on ACO-1, side 1, and including copies of wireline logs.
4. Notify District office 48 hours prior to old well workover or re-entry.
5. Prior to filing Intent, prepare a proposed plugging plan in case well is D & A, then obtain approval of plan when calling district office prior to setting surface pipe.
6. Submit plugging report (CP-4) to K.C.C. after plugging is completed.
7. Obtain an approved injection docket number before disposing of salt water.
8. Notify K.C.C. within 10 days when injection commences or terminates.
9. If an alternate 2 completion, cement in the production pipe from below any usable water to surface within 120 days of spud date.

### A Regular Section of Land 1 Mile = 5,280 Ft.

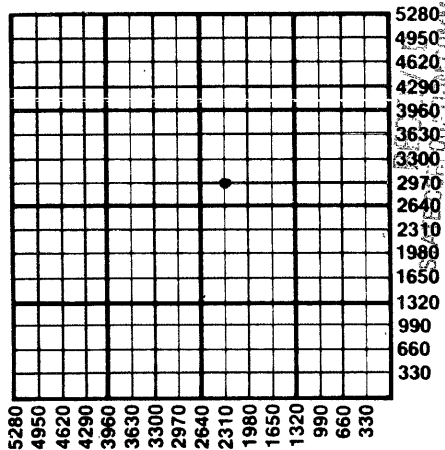

State Corporation Commission of Kansas  
Conservation Division  
200 Colorado Derby Building  
Wichita, Kansas 67202-1212  
(316) 263-3238