

CARD MUST BE TYPED

State of Kansas

CARD MUST BE SIGNED

NOTICE OF INTENTION TO DRILL

(see rules on reverse side)

✓

Expected Spud Date.....10.....20.....87
month day year

API Number 15-141-20, 235-00-00

OPERATOR: License #.....6600.....

110' S & 50' W of 22 East
SE NW SE Sec. 22 Twp. 10 S, Rg. 15W X West

Name.....DON. KARST WELL SERVICE, INC.....

Address.....Box 1316.....

City/State/Zip.....Hays, KS...67601.....

Contact Person.....Don Karst.....

Phone.....913-628-1125.....

1540..... Ft. from South Line of Section
1700..... Ft. from East Line of Section

(Note: Locate well on Section Plat on reverse side)

CONTRACTOR: License #.....5302.....

Name.....Red Tiger Drilling Co.....

City/State.....Wichita, KS...67202.....

Nearest lease or unit boundary line330..... feet

County.....Osborne.....

Lease Name...Koelling..... Well #...3.....

Ground surface elevation..... feet MSL

Domestic well within 330 feet:yes Xno

Municipal well within one mile:yes Xno

Well Drilled For: Well Class: Type Equipment:

Depth to bottom of fresh water.....

Depth to bottom of usable water ..550.....

Surface pipe by Alternate: 1 2

Surface pipe planned to be set625'.....

Conductor pipe requiredN/A.....

Projected Total Depth3385..... feet

Formation.....ARB.....

If OWWO: old well info as follows:

Operator.....

Well Name.....

Comp Date..... Old Total Depth.....

I certify that well will comply with K.S.A. 55-101, et seq., plus any equally plugging holes to KCC specification

Date 10-15-87..... Signature of Operator or Agent..... George A. Angler

For KCC Use:

BY RED TIGER DRILLING COMPANY

Conductor Pipe Required feet; Minimum Surface Pipe Required feet per Alt. ① X


This Authorization Expires 4-15-88 Effective 10-20-87 Approved By RCT 10-15-87

Must be filed with the K.C.C. five (5) days prior to commencing well
 This card void if drilling not started within six (6) months of date received by K.C.C.

Important procedures to follow:

1. Notify District office before setting surface casing.
2. Set surface casing by circulating cement to the top.
3. File completion forms ACO-1 with K.C.C. within 120 days of well spud date, following instructions on ACO-1, side 1, and including copies of wireline logs.
4. Notify District office 48 hours prior to old well workover or re-entry.
5. Prior to filing Intent, prepare a proposed plugging plan in case well is D & A, then obtain approval of plan when calling district office prior to setting surface pipe.
6. Submit plugging report (CP-4) to K.C.C. after plugging is completed.
7. Obtain an approved injection docket number before disposing of salt water.
8. Notify K.C.C. within 10 days when injection commences or terminates.
9. If an alternate 2 completion, cement in the production pipe from below any usable water to surface within 120 days of spud date.

**A Regular Section of Land
 1 Mile = 5,280 Ft.**

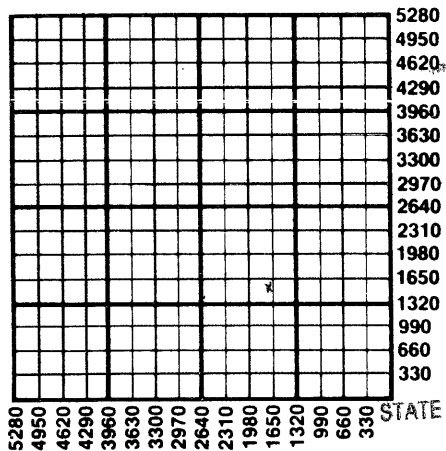

RECEIVED
 STATE CORPORATION COMMISSION

OCT 15 1987
 10-15-87
 CONSERVATION DIVISION
 Wichita, Kansas

State Corporation Commission of Kansas
 Conservation Division
 200 Colorado Derby Building
 Wichita, Kansas 67202-1212
 (316) 263-3238