

CARD MUST BE TYPED

NOTICE OF INTENTION TO DRILL

State of Kansas
(see rules on reverse side)

CARD MUST BE SIGNED

Starting Date: 4 22 85
month day year

API Number 15- 141-20,218-00-00
NW/4 SW/4 SE/4 Sec 22 Twp 10 S, Rge 15... East West
(location)

OPERATOR: License # 5900
Name Lawbanco Drilling, Inc.
Address Box 289
City/State/Zip Natoma, Kansas 67651
Contact Person Reva F. Musgrove
Phone 913 885-4676

990 Ft North from Southeast Corner of Section
2313.2 Ft West from Southeast Corner of Section
(Note: Locate well on Section Plat on reverse side)

CONTRACTOR: License #
Name Contract to be let
City/State

Nearest lease or unit boundary line 990 feet.
County Osborne
Lease Name Koelling Well# 1

Well Drilled For:	Well Class:	Type Equipment:
<input checked="" type="checkbox"/> Oil	<input type="checkbox"/> Infield	<input checked="" type="checkbox"/> Mud Rotary
<input type="checkbox"/> Gas	<input type="checkbox"/> Pool Ext.	<input type="checkbox"/> Air Rotary
<input type="checkbox"/> OWWO	<input checked="" type="checkbox"/> Wildcat	<input type="checkbox"/> Cable
<input type="checkbox"/> Swd		
<input type="checkbox"/> Inj		
<input type="checkbox"/> Expl		

Domestic well within 330 feet: yes no
Municipal well within one mile: yes no

Depth to Bottom of fresh water 50 feet
Lowest usable water formation Dakota
Depth to Bottom of usable water 500-550 feet
Surface pipe by Alternate: 1X 2
Surface pipe to be set 550+ feet
Conductor pipe if any required none feet
Ground surface elevation 1789 feet MSL

If OWWO: old well info as follows:

Operator
Well Name
Comp Date Old Total Depth
Projected Total Depth 3360 feet
Projected Formation at TD Conglomerate
Expected Producing Formations Lansing KC Conglomerate

This Authorization Expires 9-29-85
Approved By 3-29-85 [Signature]

I certify that we will comply with K.S.A. 55-101, et seq., plus eventually plugging hole to K.C.C. specifications.

Date 3-28-85 Signature of Operator or Agent [Signature]

Title President
MHC/KADHE 3/29/85
Form C-1 4/84


Must be filed with the K.C.C. five (5) days prior to commencing well
This card void if drilling not started within six (6) months of date received by K.C.C.

Important procedures to follow :

1. Notify District office before setting surface casing.
2. Set surface casing by circulating cement to the top.
3. File completion forms ACO-1 with K.C.C. within 90 days of well completion, following instructions on ACO-1, side 1, and including copies of wireline logs.
4. Notify District office 48 hours prior to old well workover or re-entry.
5. Prior to plugging, prepare a plugging plan, then obtain agreement from the appropriate district office for an approved plugging plan.
6. Submit plugging report (CP-4) to K.C.C. after plugging is completed.
7. Obtain an approved injection docket number before disposing of salt water.
8. Notify K.C.C. within 10 days when injection commences or terminates.
9. If an alternate 2 completion, cement in the production pipe from below any usable water to surface within 120 days of spud date.

RECEIVED
STATE CORPORATION COMMISSION
MAY 29 1985

**A Regular Section of Land
1 Mile 5,280 Ft.**

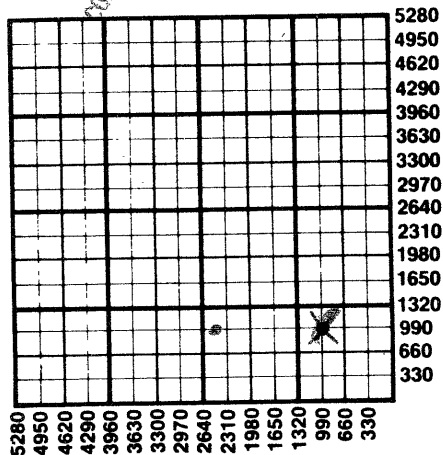

**State Corporation Commission of Kansas
Conservation Division
200 Colorado Derby Building
Wichita, Kansas 67202
(316) 263-3238**