

CARD MUST BE TYPED



State of Kansas

CARD MUST BE SIGNED

NOTICE OF INTENTION TO DRILL

(see rules on reverse side)

Starting Date ... October 29, 1985
month day year

API Number 15— 141-20,207-A00-01

OPERATOR: License # 6600
Name ... Don. Karst. Well. Service, Inc.
Address ... 201. E. 29th
City/State/Zip .. Hays, Kansas .. 67601
Contact Person ... Don. Karst.
Phone ... (913)-483-3958

_____ East
NW. SE...SE... Sec. 22... Twp... 10. S, Rg. J5..... West
..... 990..... Ft. from South Line of Section
..... 990..... Ft. from East Line of Section

(Note: Locate well on Section Plat on reverse side)

CONTRACTOR: License # ... 8241
Name Emphasis. Oil Operations
City/State .. P... Box. 506, Russell, KS... 67665-0506

Nearest lease or unit boundary line 330..... feet
County Osborne

Lease Name.. Ruggles..... Well #.. 2.....

Ground surface elevation ... 1797..... feet MSL

Well Drilled For:	Well Class:	Type Equipment:
<input checked="" type="checkbox"/> Oil	<input checked="" type="checkbox"/> Infield	<input checked="" type="checkbox"/> Mud Rotary
<input type="checkbox"/> Gas	<input type="checkbox"/> Pool Ext.	<input type="checkbox"/> Air Rotary
<input checked="" type="checkbox"/> OWWO	<input type="checkbox"/> Expl	<input type="checkbox"/> Wildcat
		<input type="checkbox"/> Cable

Domestic well within 330 feet: _____ yes no

Municipal well within one mile: _____ yes no

Surface pipe by Alternate: 1 2 _____

Depth to bottom of fresh water... 80.....

Depth to bottom of usable water ... 500 570.....

Surface pipe ~~planned to be set~~ 570. previously set.....

Projected Total Depth ... 3390..... feet

Formation ... Conglomerate.....

If OWWO: old well info as follows:

Operator ... Lawbanco Drilling, Inc,
Well Name ... L-C. Ruggles.....
Comp Date .. 10-19-84..... Old Total Depth... 3390!.....

I certify that well will comply with K.S.A. 55-101, et seq., plus eventually plugging hole to KCC specifications.

Date ... 10-2-85..... Signature of Operator or Agent *[Signature]* Title. Agent.....

[Handwritten initials]

For KCC Use:

Conductor Pipe Required feet; Minimum Surface Pipe Required feet per Alt. 2


This Authorization Expires ... 4-3-86 Approved By ... 10-3-85 *[Signature]*

Must be filed with the K.C.C. five (5) days prior to commencing well
 This card void if drilling not started within six (6) months of date received by K.C.C.

Important procedures to follow:

1. Notify District office before setting surface casing.
2. Set surface casing by circulating cement to the top.
3. File completion forms ACO-1 with K.C.C. within 90 days of well completion, following instructions on ACO-1, side 1, and including copies of wireline logs.
4. Notify District office 48 hours prior to old well workover or re-entry.
5. Prior to filing Intent, prepare a proposed plugging plan in case well is D & A, then obtain approval of plan when calling district office prior to setting surface pipe.
6. Submit plugging report (CP-4) to K.C.C. after plugging is completed.
7. Obtain an approved injection docket number before disposing of salt water.

A Regular Section of Land
1 Mile = 5,280 Ft.

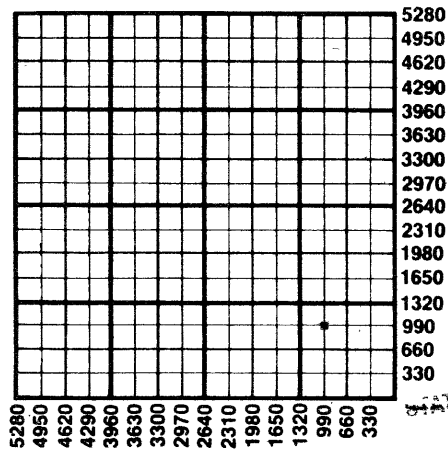

RECEIVED
 STATE CORPORATION COMMISSION
 Notice to K.C.C. within 10 days when injection commences or terminates.

OCT 3 1965

CONSERVATION DIVISION
 Wichita, Kansas

an alternate 2 completion, cement in the production pipe from below any usable water to surface within 120 days of spud date.

State Corporation Commission of Kansas
 Conservation Division
 200 Colorado Derby Building
 Wichita, Kansas 67202
 (316) 263-3238