

CARD MUST BE TYPED

State of Kansas

CARD MUST BE SIGNED

NOTICE OF INTENTION TO DRILL

(see rules on reverse side)

Starting Date September 16, 1986
month day year

API Number 15— 141-20, 228-00-00
100' N of _____ East
..SE SE. NE... Sec. 21... Twp. 10... S, Rg. 15..... West
.....3070..... Ft. from South Line of Section
.....330..... Ft. from East Line of Section

OPERATOR: License # ... 6600
Name .. Don Karst Well Service
Address .. 201 E. 9th
City/State/Zip .. Hays, KS. 67601
Contact Person. Don Karst
Phone (913)-483-3958

(Note: Locate well on Section Plat on reverse side)

Nearest lease or unit boundary line 330 feet
County .. Osborne

CONTRACTOR: License # 8241
Name Euphasis Oil Operations
City/State .. P.O. Box 506, Russell, KS. 67665

Lease Name Thompson Well # 1
Ground surface elevation ... 1805 feet MSL

Well Drilled For: Well Class: Type Equipment:
 Oil ___ SWD Infield Mud Rotary
___ Gas ___ Inj ___ Pool Ext. ___ Air Rotary
___ OWWO ___ Expl ___ Wildcat ___ Cable

Domestic well within 330 feet: ___ yes no
Municipal well within one mile: ___ yes no

If OWWO: old well info as follows:

Operator
Well Name
Comp Date Old Total Depth

Depth to bottom of fresh water 80
Depth to bottom of usable water 560
Surface pipe by Alternate: 1 2 ___
Surface pipe planned to be set 600
Conductor pipe required N/A
Projected Total Depth 3450 feet
Formation ... Arbuckle

I certify that well will comply with K.S.A. 55-101, et seq., plus eventually plugging hole to KCC specifications.

Date ... 9-11-86 Signature of Operator or Agent *[Signature]* Title ... Agent

For KCC Use:

Conductor Pipe Required feet; Minimum Surface Pipe Required 600 feet per Alt. *[Signature]*
This Authorization Expires 3-12-87 Approved By 9-12-86 *[Signature]*


[Handwritten Signature]
KCC/KCC

Must be filed with the K.C.C. five (5) days prior to commencing well
This card void if drilling not started within six (6) months of date received by K.C.C.

Important procedures to follow:

1. Notify District office before setting surface casing.
2. Set surface casing by circulating cement to the top.
3. File completion forms ACO-1 with K.C.C. within 90 days of well completion, following instructions on ACO-1, side 1, and including copies of wireline logs.
4. Notify District office 48 hours prior to old well workover or re-entry.
5. Prior to filing Intent, prepare a proposed plugging plan in case well is D & A, then obtain approval of plan when calling district office prior to setting surface pipe.
6. Submit plugging report (CP-4) to K.C.C. after plugging is completed.
7. Obtain an approved injection docket number before disposing of salt water.
8. Notify K.C.C. within 10 days when injection commences or terminates.
9. If an alternate 2 completion, cement in the production pipe from below any usable water to surface within 120 days of spud date.

A Regular Section of Land 1 Mile = 5,280 Ft.

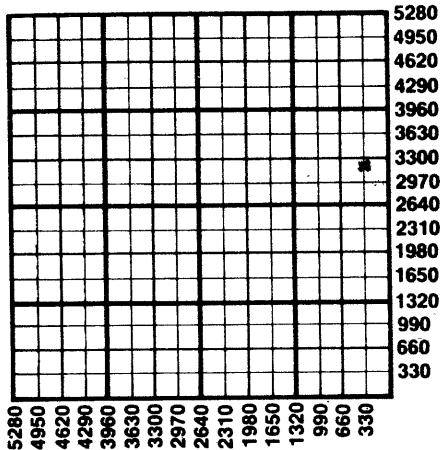

SEP 12 1986
9-12-86

State Corporation Commission of Kansas
Conservation Division
200 Colorado Derby Building
Wichita, Kansas 67202
(316) 263-3238