

Exp. 2-2-85

CORRECTION
CARD MUST BE SIGNED
8-24-84

CARD MUST BE TYPED

State of Kansas
NOTICE OF INTENTION TO DRILL
(see rules on reverse side)

Starting Date: 8-12-84
month day year

API Number 15- 163-22, 454 -00-00

OPERATOR: License # 8925

NW SE SW NE Sec. 30 Twp. 9 S, Rge 17 East West

Name Liberty Operations & Completions, Inc. (location)

Address 308 West Mill

City/State/Zip Plainville, KS 67663

Contact Person David L. Comeau

Phone 913-434-4686

* 3630 Ft North from Southeast Corner of Section

* 3630 Ft West from Southeast Corner of Section

(Note: Locate well on Section Plat on reverse side)

CONTRACTOR: License # 5665

Nearest lease or unit boundary line 990' feet.

County Rooks

Name Pioneer Drilling Company, Inc.

Lease Name Plainville Public Library # 2 Well#

City/State Plainville, KS 67663

Domestic well within 330 feet: yes no

Municipal well within one mile: yes no

Well Drilled For: Well Class: Type Equipment:

- Oil Swd Infield Mud Rotary
- Gas Inj Pool Ext. Air Rotary
- OWWO Expl Wildcat Cable

Depth to Bottom of fresh water 100 feet

Lowest usable water formation Dakota

Depth to Bottom of usable water 875 feet

Surface pipe by Alternate: 1 2

Surface pipe to be set 200 feet

Conductor pipe if any required N/A feet

Ground surface elevation feet MSL

If OWWO: old well info as follows:

Operator

Well Name

Comp Date Old Total Depth

Projected Total Depth 3458 feet

Projected Formation at TD Arbuckle

Expected Producing Formations Arbuckle

This Authorization Expires 2-2-85

Approved By 8-2-84

I certify that we will comply with K.S.A. 55-101, et seq., plus eventually plugging hole to K.C.C. specifications.


Wells: SW NE NW
4290 FSL

Date 8-21-84 Signature of Operator or Agent

Reginald L. Comeau Title

Must be filed with the K.C.C. five (5) days prior to commencing well
This card void if drilling not started within six (6) months of date received by K.C.C.

A Regular Section of Land
1 Mile = 5,280 Ft.

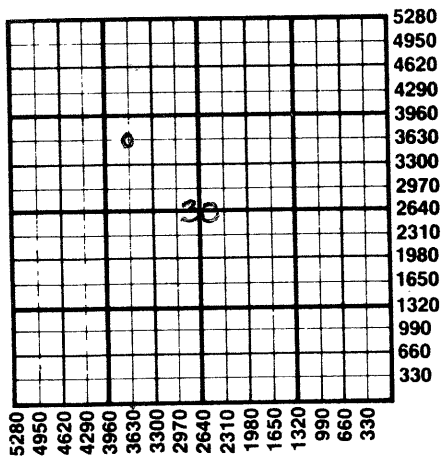

Important procedures to follow:

1. Notify District office before setting surface casing.
2. Set surface casing by circulating cement to the top.
3. File completion forms ACO-1 with K.C.C. within 90 days of well completion, following instructions on ACO-1, side 1, and including copies of wireline logs.
4. Notify District office 48 hours prior to old well workover or re-entry.
5. Prior to plugging, prepare a plugging plan, then obtain agreement from the appropriate district office for an approved plugging plan.
6. Submit plugging report (CP-4) to K.C.C. after plugging is completed.
7. Obtain an approved injection docket number before disposing of salt water.
8. Notify K.C.C. within 10 days when injection commences or terminates.
9. If an alternate 2 completion, cement in the production pipe from below any usable water to surface within 120 days of spud date.

State Corporation Commission of Kansas
Conservation Division
200 Colorado Derby Building
Wichita, Kansas 67202
(316) 263-3238

RECEIVED
STATE CORPORATION COMMISSION

AUG 23 1984
8-23-84

CONSERVATION DIVISION
Wichita, Kansas