

CARD MUST BE TYPED

State of Kansas  
**NOTICE OF INTENTION TO DRILL**

CARD MUST BE SIGNED

(see rules on reverse side)

Starting Date: 6 25 85  
month day year 3.10

API Number 15- 107-12,633-00-00

OPERATOR: License # 5756  
Name Triple-I Energy Corporation  
Address 6600 College Blvd., #310  
City/State/Zip Overland Park, KS 66211  
Contact Person Lila Highfill  
Phone (913) 345-8000

SE SW NW  
(location) Sec 24 Twp 22 S, Rge 21  
3080  
4400  
Ft North from Southeast Corner of Section  
Ft West from Southeast Corner of Section  
(Note: Locate well on Section Plat on reverse side)

CONTRACTOR: License # 5678  
Name Harold L. Brady  
City/State Paola, KS 66071

Nearest lease or unit boundary line 880 feet.  
County Linn  
Lease Name Mitchell A Well# 10-W

Well Drilled For: Well Class: Type Equipment:  
 Oil  Swd  Infield  Mud Rotary  
 Gas  Inj  Pool Ext.  Air Rotary  
 OWWO  Expl  Wildcat  Cable

Domestic well within 330 feet:  yes  no  
Municipal well within one mile:  yes  no

If OWWO: old well info as follows:  
Operator .....  
Well Name .....  
Comp Date ..... Old Total Depth .....  
Projected Total Depth 900 feet  
Projected Formation at TD .....  
Expected Producing Formations .....

Depth to Bottom of fresh water 75 ~ 100 feet  
Lowest usable water formation Dennis Limestone  
Depth to Bottom of usable water 150 feet  
Surface pipe by Alternate: 1  2   
Surface pipe to be set 20 feet  
Conductor pipe if any required ..... feet  
Ground surface elevation ..... feet MSL  
This Authorization Expires 12-25-85  
Approved By 6-25-85 RCH For KDHE

I certify that we will comply with K.S.A. 55-101, et seq., plus eventually plugging hole to K.C.C. specifications.

Date 6/25/85 Signature of Operator or Agent Ragnel Robles Title As agent

Must be filed with the K.C.C. five (5) days prior to commencing well  
 This certificate of drilling not started within six (6) months of date received by K.C.C.


RECEIVED  
 STATE CORPORATION COMMISSION

6-25-85

JUN 25 1985

Important procedures to follow:

A Regular Section of CONSERVATION DIVISION  
 1 Mile = 5,280 Feet  
 Wichita, Kansas

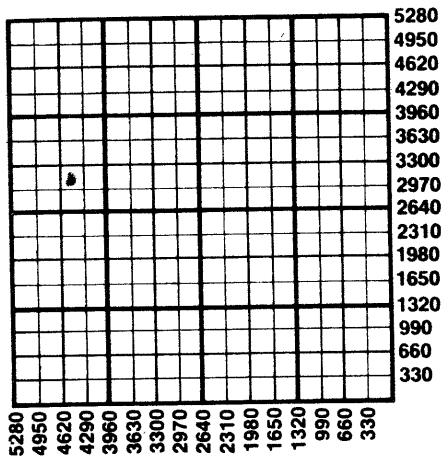

1. Notify District office before setting surface casing.
2. Set surface casing by circulating cement to the top.
3. File completion forms ACO-1 with K.C.C. within 90 days of well completion, following instructions on ACO-1, side 1, and including copies of wireline logs.
4. Notify District office 48 hours prior to old well workover or re-entry.
5. Prior to plugging, prepare a plugging plan, then obtain agreement from the appropriate district office for an approved plugging plan.
6. Submit plugging report (CP-4) to K.C.C. after plugging is completed.
7. Obtain an approved injection docket number before disposing of salt water.
8. Notify K.C.C. within 10 days when injection commences or terminates.
9. If an alternate 2 completion, cement in the production pipe from below any usable water to surface within 120 days of spud date.

State Corporation Commission of Kansas  
 Conservation Division  
 200 Colorado Derby Building  
 Wichita, Kansas 67202  
 (316) 263-3238