


15-163-08761-00-00

WELL PLUGGING RECORD

FORMATION PLUGGING RECORD

STATE OF KANSAS STATE CORPORATION COMMISSION Give All Information Completely Make Required Affidavit Mail or Deliver Report to: Conservation Division State Corporation Commission 800 Bitting Building Wichita, Kansas

Strike out upper line when reporting plugging off formations.

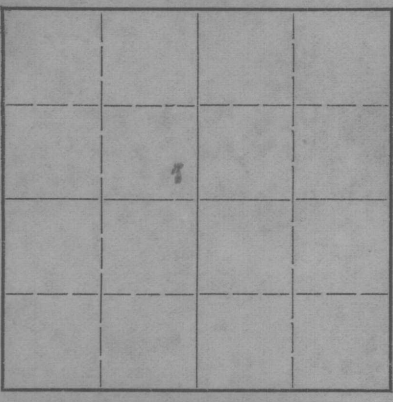

County. Sec. 13 Twp. 9 Rge. 17 (E) (W)

Location as "NE 1/4 NW 1/4 SW 1/4" or footage from lines. 330 from east 660 from south

Lease Owner Schumacher Carl Carl

Lease Name Schumacher Carl Carl Well No. 2

Office Address Tulsa Okla

Character of Well (completed as Oil, Gas or Dry Hole) Dry

Date well completed 7-30 19 47

Application for plugging filed 7-30 19 47

Application for plugging approved 7-31 19 47

Plugging commenced 7-30 19 47

Plugging completed 7-31 19 47

Reason for abandonment of well or producing formation Dry

If a producing well is abandoned, date of last production 19

Was permission obtained from the Conservation Division or its agents before plugging was commenced? Yes

Name of Conservation Agent who supervised plugging of this well Mrs. M. K. Carr

Producing formation Depth to top Bottom Total Depth of Well 3521 Feet

Show depth and thickness of all water, oil and gas formations.

Table with columns: Formation, Content, From, To, Size, Put In, Pulled Out. Includes handwritten entry: 9 3/4 197 left in cemented

Describe in detail the manner in which the well was plugged, indicating where the mud fluid was placed and the method or methods used in introducing it into the hold. If cement or other plugs were used, state the character of same and depth placed, from feet to feet for each plug set.

Handwritten log: 3521 to 3491 Cement, 3491 to 3230 mud, 3230 to 3200 cement, 3200 to 1300 mud, 1300 to 1300 cement, 1300 to 400 mud, 400 to 06 cement

(If additional description is necessary, use BACK of this sheet)

Correspondence regarding this well should be addressed to O. A. Williams, Albert Carr, or Schumacher Carl Carl, Tulsa Okla

STATE OF Kansas, COUNTY OF Barton, ss.

(employee of owner) or (owner or operator) of the above-described well, being first duly sworn on oath, says: That I have knowledge of the facts, statements, and matters herein contained and the log of the above-described well as filed and that the same are true and correct. So help me God.

(Signature) O. A. Williams, Albert Carr (Address)

SUBSCRIBED AND SWORN to before me this 28th day of August, 19 47

NOTARY PUBLIC Term Expires January 20th, 1949

My commission expires Notary Public.

Received 8/28/47

WELL PLUGGING RECORD

OR

FORMATION PLUGGING RECORD

Strike out upper line when reporting plugging off formations.

Give All Information Completely
Make Required Affidavit
Mail or Deliver Report to:
Conservation Division
State Corporation Commission
800 Bitting Building
Wichita, Kansas

Brook County. Sec. 13 Twp. 9 Rge. 17 (E) (W)

Location as "NE $\frac{1}{4}$ NW $\frac{1}{4}$ SW $\frac{1}{4}$ " or footage from lines 330 from east line South

Lease Owner S. Schumacher & Co. Well No. 2

Lease Name S. Smith Office Address

Character of Well (completed as Oil, Gas or Dry Hole) Dry

Date well completed 7-30-47 19.47

Application for plugging filed 7-30-47 19.47

Application for plugging approved 7-31-47 19.47

Plugging commenced 7-30-47 19.47

Plugging completed 7-30-47 19.47

Reason for abandonment of well or producing formation Dry

If a producing well is abandoned, date of last production 19

Was permission obtained from the Conservation Division or its agents before plugging was commenced? yes

Name of Conservation Agent who supervised plugging of this well Mr. Kerr

Producing formation Depth to top Bottom Total Depth of Well 3521 Feet

Show depth and thickness of all water, oil and gas formations.


OIL, GAS OR WATER RECORDS

CASING RECORD

Formation	Content	From	To	Size	Put In	Pulled Out
				9 3/8	177	left in cement

Describe in detail the manner in which the well was plugged, indicating where the mud fluid was placed and the method or methods used in introducing it into the hold. If cement or other plugs were used, state the character of same and depth placed, from feet to feet for each plug set.

3521 to 3491 cement
3491 to 3230 mud
3230 to 3200 cement
3200 to 1300 mud
1300 to 1300 cement
1300 to 400 mud
400 to 000 cement

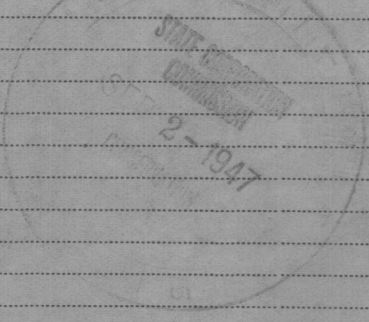

(If additional description is necessary, use BACK of this sheet)

Correspondence regarding this well should be addressed to Albert Kerr

Address Dr. Schumacher & Co.

STATE OF Kansas, COUNTY OF Barton

(employee of owner) or (owner or operator) of the above-described well, being first duly sworn on oath, says: That I have knowledge of the facts, statements, and matters herein contained and the log of the above-described well as filed and that the same are true and correct. So help me God.

(Signature) Albert Kerr (Address)

SUBSCRIBED AND SWORN to before me this 28th day of August, 1947

NOTARY PUBLIC My commission expires January 20th, 1949 Notary Public.

PLUGGING FILE SEC 13 T 9 R 17W BOOK PAGE 129 LINE 15

21-6858-RS 2-47-5M

SCHERMERHORN OIL CORPORATION

SMITH WELL #2

Section 13-9S-17W,
Rooks County, Kansas

9-5/8" O.D. casing cemented at 168'
Dry Hole

Drilling commenced 7-13-47
Drilling completed 7-30-47

FROM	TO	FORMATION	REMARKS
0'	177'	Shale	9-5/8" O.D. casing cemented with 88 sacks Lone Star cement at 168'.
177	940	Shale and shells	
940	970	Dakota sand	
970	1070	Shale and shells	
1070	1200	Shale, shells and red bed	
1200	1340	Anhydrite	
1340	1570	Red bed and shale	
1570	1830	Shale and shells	
1830	1970	Shale and lime	
1970	2145	lime and shale	
2145	2220	Shale	
2220	2260	Lime and shale	
2260	2300	Shale and shells	
2300	2390	Shale and lime	
2390	2475	Lime and shale	
2475	2535	Shale and lime	
2535	2770	lime and shale	
2770	2780	Shale	
2780	2926	Lime and shale	
2926	3521	Lime	
	T.D. 3521'		Dry Hole

