

15-163-01076-00-00


STATE OF KANSAS
STATE CORPORATION COMMISSION

Form CP-4

All information Completely
Required Affidavit
For Deliver Report to:
Conservation Division
State Corporation Commission
211 No. Broadway
Wichita, Kansas

WELL PLUGGING RECORD

NORTH

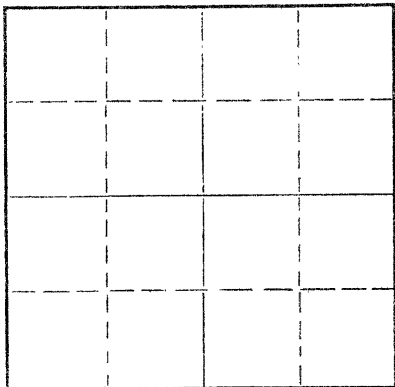

Locate well correctly on above
Section Plat

Rocks _____ County. Sec. 14 Twp. 9S Rge. 17W (E) _____ (W)
Location as "NE/CNW/SW" or footage from lines _____ SW SW SW
Lease Owner D & D Drilling Company, Inc.
Lease Name Westhusin Well No. 1
Office Address 307 Schweiter Building
Character of Well (completed as Oil, Gas or Dry Hole) Dry Hole
Date well completed 6-13-64 19____
Application for plugging filed 6-17-64 19____
Application for plugging approved 6-13-64 19____
Plugging commenced 6-13-64 19____
Plugging completed 6-13-64 19____
Reason for abandonment of well or producing formation Dry Hole

If a producing well is abandoned, date of last production _____ 19____
Was permission obtained from the Conservation Division or its agents before plugging was commenced? _____

Name of Conservation Agent who supervised plugging of this well Eldon Petty, Box 325, Hays, Kansas
Producing formation _____ Depth to top _____ Bottom _____ Total Depth of Well 3530' Feet
Show depth and thickness of all water, oil and gas formations.

OIL, GAS OR WATER RECORDS

CASING RECORD

FORMATION	CONTENT	FROM	TO	SIZE	PUT IN	PULLED OUT
Surface hole		0	228'	8 5/8"	6-5-64	

Describe in detail the manner in which the well was plugged, indicating where the mud fluid was placed and the method or methods used in introducing it into the hole. If cement or other plugs were used, state the character of same and depth placed, from _____ feet to _____ feet for each plug set.

Filled hole with heavy drilling mud and set
plug #1 at 550' with 25 sacks cement. Set
plug #2 at 220' with 20 sacks cement. Set
plug #3 at 40' with 20 sacks and 1/4 sack
hulls.

RECEIVED
STATE CORPORATION COMMISSION
6/18/64
JUN 18 1964

CONSERVATION DIVISION
Wichita, Kansas

(If additional description is necessary, use BACK of this sheet)

Name of Plugging Contractor D & D Drilling Company, Inc.
Address 307 Schweiter Building, Wichita, Kansas

STATE OF Kansas, COUNTY OF Sedgwick, ss.
James R. Daniels (employee of owner) or (owner or operator) of the above-described well, being first duly sworn on oath, says: That I have knowledge of the facts, statements, and matters herein contained and the log of the above described well as filed and that the same are true and correct. So help me God.

(Signature) James R. Daniels
James R. Daniels
307 Schweiter Bldg., Wichita, Kansas
(Address)

SWORN TO before me this 17th day of June, 19 64
My commission expires 11-18-66
Colleen Chapple
Colleen Chapple Notary Public.



15-163-01076-00-00

ROTARY DRILLING LOG

OPERATOR: D & D Drilling Co., Inc. COMM: 6-5-64
 CONTRACTOR: D & D Drilling Co., Inc. COMP: 6-13-64
 WELL: WESTHUSIN #1
 LOCATION: SW SW SW Sec. 14-9S-17W ELEV.: 2053 R.B.
 COUNTY: Rooks, Kansas

Formation	Depth	Remarks
Sand & Shale	228'	Set 228' of 8 5/8" casing, cemented with 185 sacks.
Shale & Sand	1263'	
Anhy.	1356'	
Shale	1880'	
Shale & Lime	3065'	
Lime	3480'	
Lime & Shale	3530'	
Rotary Total Depth	3530'	D & A

RECEIVED
 STATE CORPORATION COMMISSION
 6/18/64
 JUN 18 1964

CONSERVATION DIVISION
 Wichita, Kansas

A F F I D A V I T

State of Kansas)
) SS
 County of Sedgwick)

I, James R. Daniels of lawful age, being duly and solemnly sworn on oath says: I am a resident of Wichita, Sedgwick County, Kansas, and I hereby know and on oath state, the above drilling log covering the Westhusin #1 located in the SW SW SW of Section 14-9S-17W, Rooks County, Kansas is true and correct to the best of my knowledge and belief. Further affiant saith not.

D & D Drilling Company, Inc.

By James R. Daniels
 James R. Daniels

Subscribed and sworn to before me this 17th day of June, 1964.

My Commission Expires
11-18-64

Colleen A. Chapple
 Colleen Chapple - Notary Public