

CARD MUST BE TYPED

# State of Kansas **NOTICE OF INTENTION TO DRILL** (see rules on reverse side)

CARD MUST BE SIGNED

Starting Date: ..... 12 ..... 1 ..... 1984  
 month day year

OPERATOR: License # ..... 5769

Name ..... Harold Krueger Co.

Address ..... Box 247

City/State/Zip ..... Natoma, Kansas ..... 67651

Contact Person ..... Dean Wineland

Phone ..... 913-885-4701

CONTRACTOR: License # ..... 6427

Name ..... Rosencrantz-Bemis Drilling

City/State ..... Great Bend, Kansas

## Well Drilled For:

☐ Oil ☒ Swd

☐ Gas ☐ Inj

☐ OWWO ☐ Expl

## Well Class:

☒ Infield

☐ Pool Ext.

☐ Wildcat

## Type Equipment:

☒ Mud Rotary

☐ Air Rotary

☐ Cable

If OWWO: old well info as follows:

Operator .....

Well Name .....

Comp Date ..... Old Total Depth .....

Projected Total Depth ..... 1390 ..... feet

Projected Formation at TD ..... Anhydrite

Expected Producing Formations .....

I certify that we will comply with K.S.A. 55-101, et seq., plus eventually plugging hole to K.C.C. specifications.

Date ..... 11-26-84 ..... Signature of Operator or Agent ..... Dean Wineland

API Number 15- 163-22,574-00-00

NW NW NW Sec 15 Twp 9 S, Rge 17 ☐ East  
 (location) ☒ West

5080 ..... Ft North from Southeast Corner of Section

4820 ..... Ft West from Southeast Corner of Section

(Note: Locate well on Section Plat on reverse side)

Nearest lease or unit boundary line ..... 1000 ..... feet.

County ..... Rooks

Lease Name ..... Carmicheal Well# 5

Domestic well within 330 feet: ☐ yes ☒ no

Municipal well within one mile: ☐ yes ☒ no

Depth to Bottom of fresh water ..... 150 ..... feet

Lowest usable water formation ..... Dakota

Depth to Bottom of usable water ..... 825 ..... feet

Surface pipe by Alternate: 1 ☐ 2 ☒

Surface pipe to be set ..... 400 ..... feet

Conductor pipe if any required ..... feet

Ground surface elevation ..... 2088 ..... feet MSL

This Authorization Expires ..... 5-27-85


Approved By ..... 11-27-84

Field Supt.

Must be filed with the K.C.C. five (5) days prior to commencing well  
This card void if drilling not started within six (6) months of date received by K.C.C.

**Important procedures to follow :**

**A Regular Section of Land  
1 Mile = 5,280 Ft.**

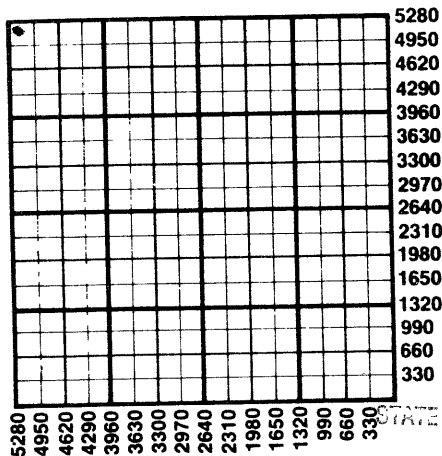

1. Notify District office before setting surface casing.
2. Set surface casing by circulating cement to the top.
3. File completion forms ACO-1 with K.C.C. within 90 days of well completion, following instructions on ACO-1, side 1, and including copies of wireline logs.
4. Notify District office 48 hours prior to old well workover or re-entry.
5. Prior to plugging, prepare a plugging plan, then obtain agreement from the appropriate district office for an approved plugging plan.
6. Submit plugging report (CP-4) to K.C.C. after plugging is completed.
7. Obtain an approved injection docket number before disposing of salt water.
8. Notify K.C.C. within 10 days when injection commences or terminates.
9. If an alternate 2 completion, cement in the production pipe from below any usable water to surface within 120 days of spud date.

RECEIVED

STATE CORPORATION COMMISSION

11/27/84  
NOV 27 1984

State Corporation Commission of Kansas  
Conservation Division  
200 Colorado Derby Building  
Wichita, Kansas 67202  
(316) 263-3238

CONSERVATION DIVISION  
Wichita, Kansas