

CARD MUST BE TYPED

State of Kansas

CARD MUST BE SIGNED

NOTICE OF INTENTION TO DRILL

(see rules on reverse side)

Expected Spud Date. JUNE 23, 1987
 month day year

OPERATOR: License # #8952
 Name C & E PRODUCTION, INC.
 Address ROUTE 1
 City/State/Zip BLUE MOUND, KANSAS 66010
 Contact Person. JERRY EWING
 Phone (913) 756-2383

CONTRACTOR: License # 6451
 Name BIG "E" DRILLING
 City/State RR 1, CENTERVILLE, KS 66014

Well Drilled For:	Well Class:	Type Equipment:
☒ Oil	☐ Storage	☐ Infield
☐ Gas	☐ Inj	☐ Pool Ext.
☐ OWWO	☐ Expl	☒ Wildcat
		☐ Mud Rotary
		☒ Air Rotary
		☐ Cable

If OWWO: old well info as follows:

Operator

Well Name

Comp Date Old Total Depth

I certify that well will comply with K.S.A. 55-101, et seq., plus eventually plugging hole to KCC specifications.

Date 6-23-87 Signature of Operator or Agent G. Engleman Title AS AGENT

For KCC Use:

Conductor Pipe Required feet; Minimum Surface Pipe Required 20 feet per Alt. Y (2)

This Authorization Expires 12-23-87 Approved By Ref. 6-24-87

* WAS: 1170 FSL, NW-SW-SW

API Number 15— 107-22, 869-00-00 * "CORRECTION"
 NW NW SW Sec. 25 Twp 22 S, Rg. 21 East
 2170 Ft. from South Line of Section
 4800 Ft. from East Line of Section

(Note: Locate well on Section Plat on reverse side)

Nearest lease or unit boundary line 330 feet
 County LINN
 Lease Name PAUL JOHNSON Well # 1-87
 Ground surface elevation feet MSL
 Domestic well within 330 feet: ☐ yes ☒ no
 Municipal well within one mile: ☐ yes ☒ no
 Depth to bottom of fresh water
 Depth to bottom of usable water 150
 Surface pipe by Alternate: 1 ☒ 2
 Surface pipe planned to be set 20
 Conductor pipe required
 Projected Total Depth 900 feet
 Formation BURGESS


ORIG REC'd 6-23-87

Must be filed with the K.C.C. five (5) days prior to commencing well
This card void if drilling not started within six (6) months of date received by K.C.C.

Important procedures to follow:

1. Notify District office before setting surface casing.
2. Set surface casing by circulating cement to the top.
3. File completion forms ACO-1 with K.C.C. within 120 days of well spud date, following instructions on ACO-1, side 1, and including copies of wireline logs.
4. Notify District office 48 hours prior to old well workover or re-entry.
5. Prior to filing Intent, prepare a proposed plugging plan in case well is D & A, then obtain approval of plan when calling district office prior to setting surface pipe.
6. Submit plugging report (CP-4) to K.C.C. after plugging is completed.
7. Obtain an approved injection docket number before disposing of salt water.
8. Notify K.C.C. within 10 days when injection commences or terminates.

A Regular Section of Land
1 Mile = 5,280 Ft.

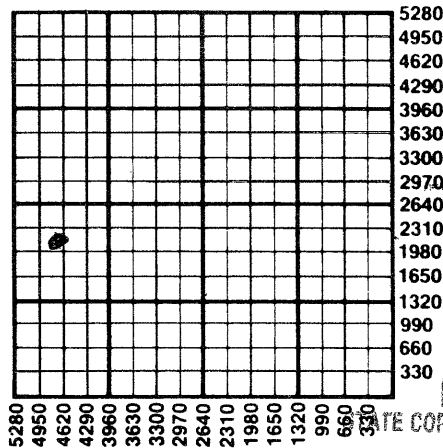

RECEIVED

STATE CORPORATION COMMISSION

JUN 24 1987

CONSERVATION DIVISION
Wichita, Kansas

Section alternate 2 completion, cement in the production pipe from below any usable water to surface within 120 days of spud date.

State Corporation Commission of Kansas
Conservation Division
200 Colorado Derby Building
Wichita, Kansas 67202-1212
(316) 263-3238

6-24-87