

CARD MUST BE TYPED

State of Kansas

CARD MUST BE SIGNED

NOTICE OF INTENTION TO DRILL

(see rules on reverse side)

Starting Date 12 22 1986
month day year

API Number 15- 107-22,831-00-00

OPERATOR: License # 9102

App. SW..SW SE Sec... 18 Twp... 22 S, Rg... 22... East

Name Mico Oil & Gas

..... 165' Ft. from South Line of Section

Address P.O. Box 281

..... 2145 Ft. from East Line of Section

City/State/Zip Paola, KS 66071

(Note: Locate well on Section Plat on reverse side)

Contact Person Ernie Pratt

Nearest lease or unit boundary line 495 feet

Phone 913-294-4326

County..... Linn

CONTRACTOR: License #

Lease Name..... Wright Well # 2

Name unknown

Ground surface elevation na feet MSL

City/State

Domestic well within 330 feet: _____ yes no

Well Drilled For: Well Class: Type Equipment:

Municipal well within one mile: _____ yes no

Oil _____ SWD Infield Mud Rotary

Depth to bottom of fresh water..... 20

_____ Gas _____ Inj _____ Pool Ext. _____ Air Rotary

Depth to bottom of usable water 150

_____ OWWO _____ Expl _____ Wildcat _____ Cable

Surface pipe by Alternate: 1 _____ 2

IF OWWO: old well info as follows:

Surface pipe planned to be set 20

Operator

Conductor pipe required

Well Name

Projected Total Depth 700 feet

Comp Date Old Total Depth.....

Formation

I certify that well will comply with K.S.A. 55-101, et seq., plus eventually plugging hole to KCC specifications.

Date 12/18/86 Signature of Operator or Agent *Edwin Jackson* Title as agent.....

For KCC Use:

Conductor Pipe Required feet; Minimum Surface Pipe Required 20 feet per Alt. 4 (2)

This Authorization Expires 6-18-87 Approved By 12-18-86

*


RCH/KCC

Must be filed with the K.C.C. five (5) days prior to commencing well
This card void if drilling not started within six (6) months of date received by K.C.C.

Important procedures to follow:

1. Notify District office before setting surface casing.
2. Set surface casing by circulating cement to the top.
3. File completion forms ACO-1 with K.C.C. within 90 days of well completion, following instructions on ACO-1, side 1, and including copies of wireline logs.
4. Notify District office 48 hours prior to old well workover or re-entry.
5. Prior to filing Intent, prepare a proposed plugging plan in case well is D & A, then obtain approval of plan when calling district office prior to setting surface pipe.
6. Submit plugging report (CP-4) to K.C.C. after plugging is completed.
7. Obtain an approved injection docket number before disposing of salt water.
8. Notify K.C.C. within 10 days when injection commences or terminates.
9. If an alternate 2 completion, cement in the production pipe from below any usable water to surface within 120 days of spud date.

**A Regular Section of Land
1 Mile = 5,280 Ft.**

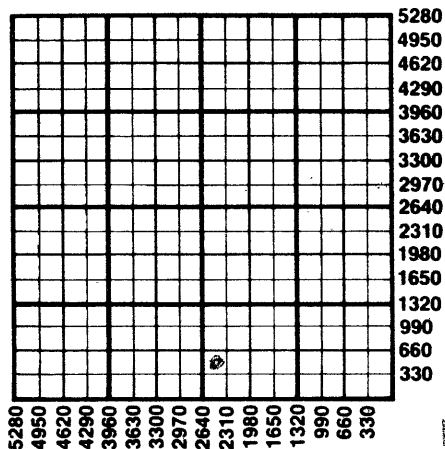

RECEIVED
STATE CORPORATION COMMISSION

DEC 18 1986
12-18-86
CONSERVATION DIVISION
Wichita, Kansas

State Corporation Commission of Kansas
Conservation Division
200 Colorado Derby Building
Wichita, Kansas 67202
(316) 263-3238