

\* Bottom Hole Location  
**CORRECTED**  
1-24-07

RECEIVED  
KANSAS CORPORATION COMMISSION  
KANSAS CORPORATION COMMISSION  
JAN 16 2007  
CONSERVATION DIVISION  
WICHITA, KS

Form C-1  
December 2002  
Form must be Typed  
Form must be Signed  
All blanks must be Filled

For KCC Use:  
Effective Date: 1-28-07  
District #: 4  
SGA?  Yes  No

KANSAS CORPORATION COMMISSION  
OIL & GAS CONSERVATION DIVISION  
**NOTICE OF INTENT TO DRILL**  
Must be approved by KCC five (5) days prior to commencing work

Expected Spud Date February 01 2007  
month day year

Spot SW - SW - SE Sec. 18 Twp. 07 S. R. 39  
 East  
 West  
125 feet from  N /  S Line of Section  
2,450' feet from  E /  W Line of Section  
Is SECTION  Regular  Irregular?

OPERATOR: License# 33019  
Name: Rosewood Resources, Inc.  
Address: 2711 N. Haskell Ave. - Suite 2800, LB #22  
City/State/Zip: Dallas, Texas 75205  
Contact Person: Storm Sands  
Phone: 214-756-6806

(Note: Locate well on the Section Plat on reverse side)  
County: Sherman  
Lease Name: Ihrig, O. Well #: 34-18H  
Field Name: Goodland

CONTRACTOR: License# 33532  
Name: Advanced Drilling Technologies, LLC

Is this a Prorated / Spaced Field?  Yes  No  
Target Formation(s): Niobrara

Well Drilled For: Well Class: Type Equipment:  
 Oil  Enh Rec  Infield  Mud Rotary  
 Gas  Storage  Pool Ext.  Air Rotary  
 OWWO  Disposal  Wildcat  Cable  
Seismic: # of Holes  Other

Nearest Lease or unit boundary: 330'  
Ground Surface Elevation: 3,603' feet MSL  
Water well within one-quarter mile:  Yes  No  
Public water supply well within one mile:  Yes  No

If OWWO: old well information as follows:  
Operator: \_\_\_\_\_  
Well Name: \_\_\_\_\_  
Original Completion Date: \_\_\_\_\_ Original Total Depth: \_\_\_\_\_

Depth to bottom of fresh water: 275'  
Depth to bottom of usable water: 275'  
Surface Pipe by Alternate:  1  2  
Length of Surface Pipe Planned to be set: 325'

Directional, Deviated or Horizontal wellbore?  Yes  No  
If Yes, true vertical depth: 1,125'

Length of Conductor Pipe required: None  
Projected Total Depth: 1215 TVD  
Formation at Total Depth: Niobrara

\* Bottom Hole Location: 125' FSL 2,450' FEL 2,300' FSL 1,300' FEL  
KCC DKT #: 07CONS-128-CHOR

Water Source for Drilling Operations:  
 Well  Farm Pond  Other XXX  
DWR Permit #: \_\_\_\_\_  
(Note: Apply for Permit with DWR )

\* WAS: Bottom Hole Location 125' FSL 2450' FEL  
IS: " " " 2300' FSL 1300' FEL (Per Plat, Side Two C-1)  
**AFFIDAVIT**

Will Cores be taken?  Yes  No  
If Yes, proposed zone: \_\_\_\_\_

The undersigned hereby affirms that the drilling, completion and eventual plugging of this well will comply with K.S.A. 55 et. seq.  
It is agreed that the following minimum requirements will be met:

1. Notify the appropriate district office **prior** to spudding of well;
2. A copy of the approved notice of intent to drill **shall be** posted on each drilling rig;
3. The minimum amount of surface pipe as specified below **shall be set** by circulating cement to the top; in all cases surface pipe **shall be set** through all unconsolidated materials plus a minimum of 20 feet into the underlying formation.
4. If the well is dry hole, an agreement between the operator and the district office on plug length and placement is necessary **prior to plugging**;
5. The appropriate district office will be notified before well is either plugged or production casing is cemented in;
6. If an ALTERNATE II COMPLETION, production pipe shall be cemented from below any usable water to surface within **120 days** of spud date.  
Or pursuant to Appendix "B" - Eastern Kansas surface casing order #133,891-C, which applies to the KCC District 3 area, alternate II cementing must be completed within 30 days of the spud date or the well shall be plugged. **In all cases, NOTIFY district office** prior to any cementing.

I hereby certify that the statements made herein are true and to the best of my knowledge and belief.

Date: January 12, 2007 Signature of Operator or Agent: [Signature] Title: Lease Analyst

For KCC Use ONLY  
API # 15: 181-20499-01-00  
Conductor pipe required: None feet  
Minimum surface pipe required: 325 feet per All. 1  
Approved by: [Signature]  
This authorization expires: 7-23-07  
(This authorization void if drilling not started within 6 months of approval date.)  
Spud date: \_\_\_\_\_ Agent: \_\_\_\_\_

- Remember to:
- File Drill Pit Application (form CDP-1) with Intent to Drill;
  - File Completion Form ACO-1 within 120 days of spud date;
  - File acreage attribution plat according to field proration orders;
  - Notify appropriate district office 48 hours prior to workover or re-entry;
  - Submit plugging report (CP-4) after plugging is completed;
  - Obtain written approval before disposing or injecting salt water.
- If this permit has expired (See: authorized expiration date) please check the box below and return to the address below.  
 Well Not Drilled - Permit Expired  
Signature of Operator or Agent: \_\_\_\_\_  
Date: \_\_\_\_\_

Mail to: KCC - Conservation Division, 130 S. Market - Room 2078, Wichita, Kansas 67202

18  
7  
39W

**IN ALL CASES PLOT THE INTENDED WELL ON THE PLAT BELOW**

*Plat of acreage attributable to a well in a prorated or spaced field*

**If the intended well is in a prorated or spaced field, please fully complete this side of the form.** If the intended well is in a prorated or spaced field complete the plat below showing that the well will be properly located in relationship to other wells producing from the common source of supply. Please show all the wells and within 1 mile of the boundaries of the proposed acreage attribution unit for gas wells and within 1/2 mile of the boundaries of the proposed acreage attribution unit for oil wells.

API No. 15 - 181-20499-01-00  
 Operator: Rosewood Resources, Inc.  
 Lease: Ihrig, O.  
 Well Number: 34-18H  
 Field: Goodland  
 Number of Acres attributable to well: 160  
 QTR / QTR / QTR of acreage: SW - SW - SE


Location of Well: County: Sherman  
125 feet from  N /  S Line of Section  
2,450' feet from  E /  W Line of Section  
 Sec. 18 Twp. 07 S. R. 39  East  West

Is Section:  Regular or  Irregular

**If Section is Irregular, locate well from nearest corner boundary.**  
 Section corner used:  NE  NW  SE  SW


**PLAT**

*(Show location of the well and shade attributable acreage for prorated or spaced wells.)  
 (Show footage to the nearest lease or unit boundary line.)*

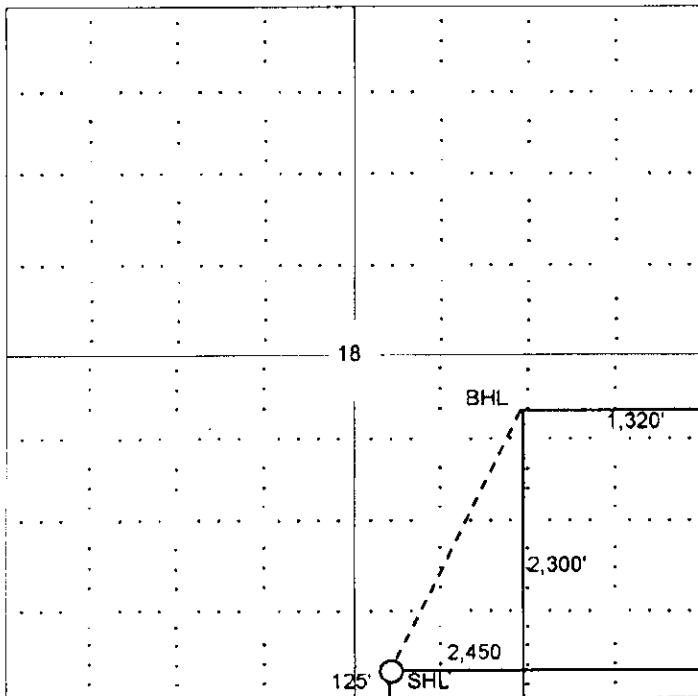

**NOTE: in all cases locate the spot of the proposed drilling location.**

RECEIVED  
 KANSAS CORPORATION COMMISSION  
 JAN 16 2007  
 CONSERVATION DIVISION  
 WICHITA, KS

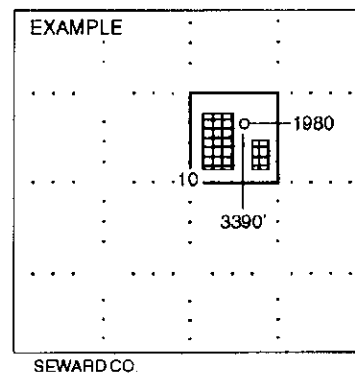

**In plotting the proposed location of the well, you must show:**

1. The manner in which you are using the depicted plat by identifying section lines, i.e. 1 section, 1 section with 8 surrounding sections, 4 sections, etc.
2. The distance of the proposed drilling location from the section's south / north and east / west.
3. The distance to the nearest lease or unit boundary line.
4. If proposed location is located within a prorated or spaced field a certificate of acreage attribution plat must be attached: (CO-7 for oil wells; CG-8 for gas wells).