

KANSAS CORPORATION COMMISSION  
OIL & GAS CONSERVATION DIVISION  
**WELL PLUGGING APPLICATION**  
Please TYPE Form and File ONE Copy

Form CP-1  
September 2003  
This Form must be Typed  
Form must be Signed  
All blanks must be Filled

API # 15 - 187-20,939 - 00 - 00 (Identifier Number of this well). This must be listed for wells drilled since 1967; if no API # was issued, indicate original spud or completion date 11-30-00.

Well Operator: Pickrell Drilling Company, Inc. KCC License #: 5123  
(Owner / Company Name) (Operator's)

Address: 100 S. Main, Suite 505 City: Wichita

State: Kansas Zip Code: 67202 Contact Phone: ( 316 ) 262 - 8427

Lease: Nairn AC Well #: 2 Sec. 30 Twp. 30S S. R. 40W  East  West

NE - N/2 - NW - SW Spot Location / QQQQ County: Stanton

2450 Feet (in exact footage) From  North /  South (from nearest outside section corner) Line of Section (Not Lease Line)

670 Feet (in exact footage) From  East /  West (from nearest outside section corner) Line of Section (Not Lease Line)

Check One:  Oil Well  Gas Well  D&A  Cathodic  Water Supply Well  
 SWD Docket # \_\_\_\_\_  ENHR Docket # \_\_\_\_\_  Other: \_\_\_\_\_

Conductor Casing Size: \_\_\_\_\_ Set at: \_\_\_\_\_ Cemented with: \_\_\_\_\_ Sacks

Surface Casing Size: 8 5/8 Set at: 1625 Cemented with: 700 Sacks

Production Casing Size: 4 1/2 Set at: 5387 Cemented with: 200 Sacks

List (ALL) Perforations and Bridgeplug Sets: 5355-5358 & 5360-5368

Elevation: 3355 ( G.L. /  K.B.) T.D.: 5389 P.B.T.D.: 5384 ~~Anhydrite~~ Depth: Heebner 3628 (-277)  
(Stone Corral Formation)

Condition of Well:  Good  Poor  Casing Leak  Junk in Hole

Proposed Method of Plugging (attach a separate page if additional space is needed): Plug back with sand to 5300 ft. Use dump bailer to spot 5 sx. cement on top of sand. Cut and recover casing spotting cement plugs as directed by KCC Representative.

RECEIVED

Is Well Log attached to this application as required?  Yes  No Is ACO-1 filed?  Yes  No

NOV 28 2006

If not explain why? \_\_\_\_\_

KCC WICHITA

Plugging of this Well will be done in accordance with K.S.A. 55-101 et. seq. and the Rules and Regulations of the State Corporation Commission.

List Name of Company Representative authorized to be in charge of plugging operations: \_\_\_\_\_

Ed Mondero Phone: ( 620 ) 793 - 2315

Address: P.O. Box 375 City / State: Ness City, Kansas 67560

Plugging Contractor: Quality Well Service KCC License #: 31925

Address: 401 West Main, Lyons, Kansas 67554 Phone: ( 620 ) 727 - 3410  
(Company Name) (Contractor's)

Proposed Date and Hour of Plugging (if known?): March 5, 2007


Payment of the Plugging Fee (K.A.R. 82-3-118) will be guaranteed by Operator or Agent

Date: 11-27-06 Authorized Operator / Agent: \_\_\_\_\_  
(Signature)

Mail to: KCC - Conservation Division, 130 S. Market - Room 2078, Wichita, Kansas 67202

New Completion     Workover  
re-

Oil Company \_\_\_\_\_ Well No. 2 Field \_\_\_\_\_ Lease Nairu "A"  
Company Man \_\_\_\_\_ Date Drilled 11/00 County Stanton State Kansas

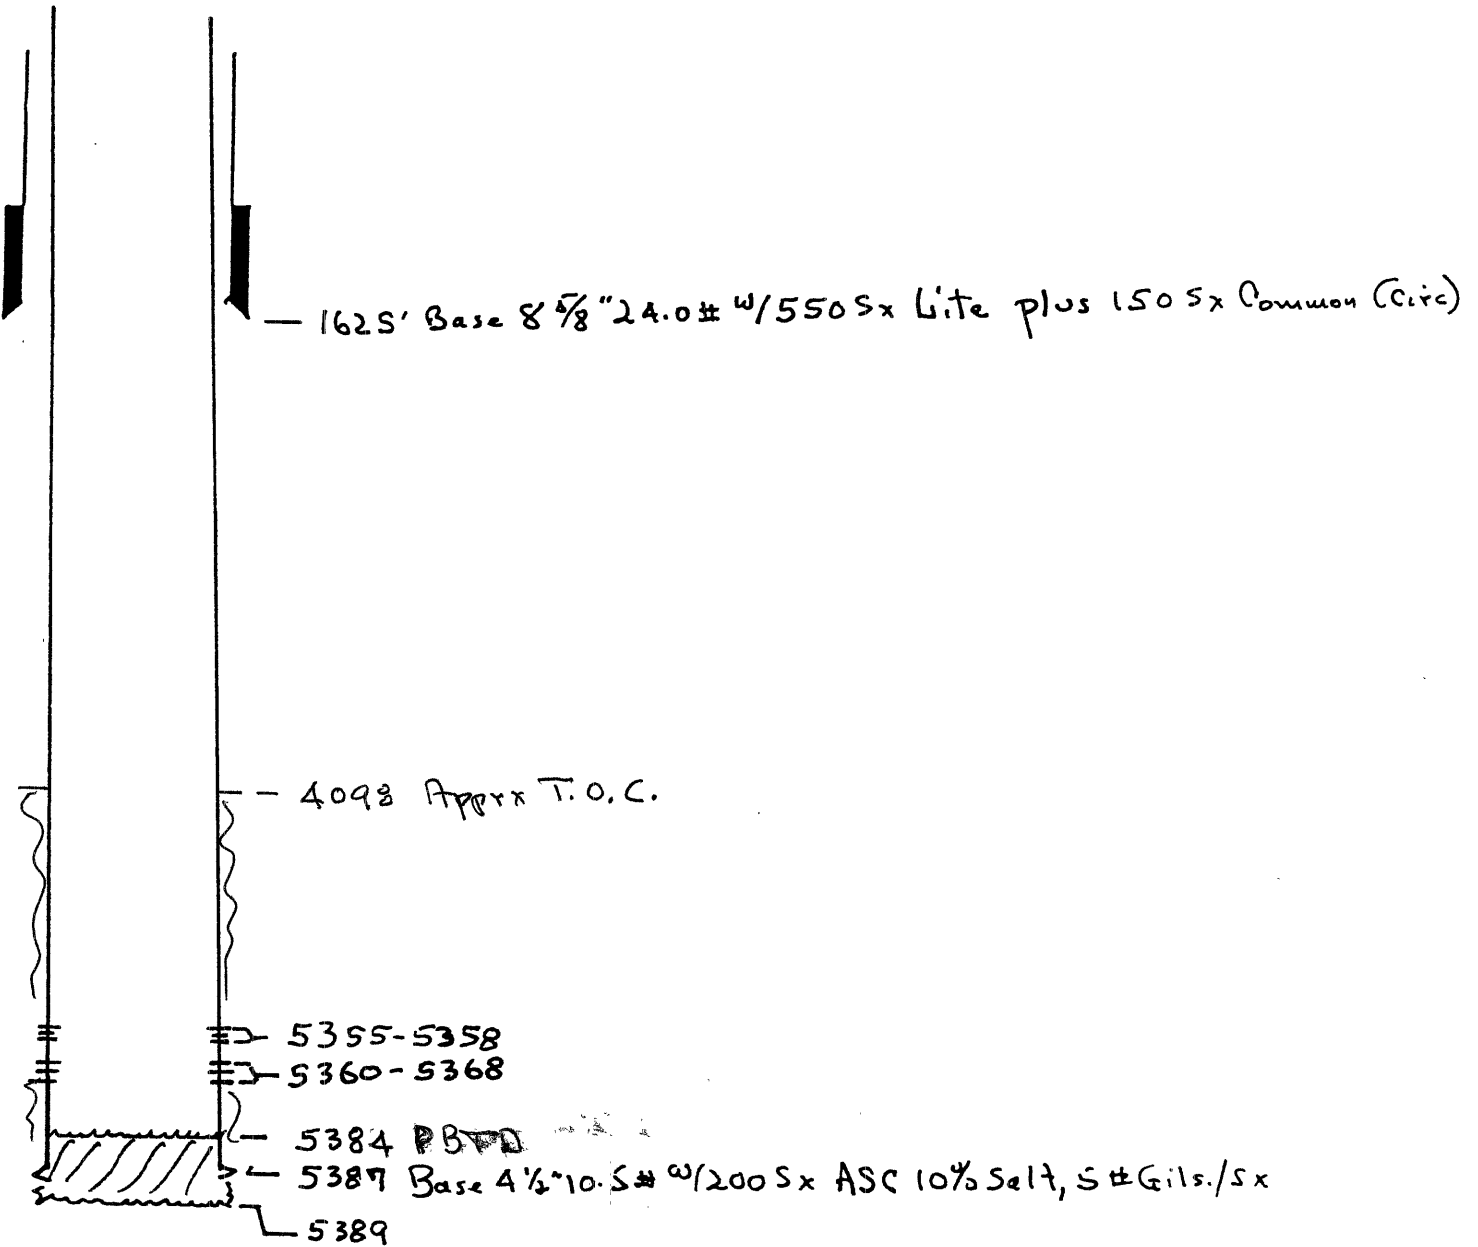

RECEIVED  
NOV 28 2006  
KCC WICHITA

# KANSAS

CORPORATION COMMISSION

Kathleen Sebelius, Governor    Brian J. Moline, Chair    Robert E. Krehbiel, Commissioner    Michael C. Moffet, Commissioner

## NOTICE OF RECEIPT OF WELL PLUGGING APPLICATION (CP-1)

Pickrell Drilling Company, Inc.  
100 South Main - Suite 505  
Wichita, KS 67202-3738

December 04, 2006

Re: NAIRN A-C #2  
API 15-187-20939-00-00  
N2NWSW 30-30S-40W, 2540 FSL 670 FWL  
STANTON COUNTY, KANSAS

Dear Operator:

This letter is to notify you that the Conservation Division is in receipt of your plugging proposal, form CP-1, for the above-captioned well.

Your CP-1 has been reviewed by the Conservation Division central office for completeness and to verify license numbers. The plugging proposal will now be forwarded to the district office listed below for review of your proposed method of plugging.

**Please contact the district office for approval of your proposed plugging method at least five (5) days before plugging the well, pursuant to K.A.R. 82-3-113 (b). If a workover pit will be used during the plugging of the well it must be permitted. A CDP-1 form must be filed and approved prior to the use of the pit.**

The Conservation Division's review of form CP-1, either in the central or district office, does not include an inquiry into well ownership or the filing operator's legal right to plug the well.

**This notice in no way constitutes authorization to plug the above-captioned well by persons not having legal rights of ownership or interest in the well. This notice is void after ninety (90) days from the above date.**

Sincerely



Barry Metz  
Deputy Director

District: #1  
210 E Frontview, Suite A  
Dodge City, KS 67801  
(620) 225-8888