


15-163-00549-00-00

STATE OF KANSAS
STATE CORPORATION COMMISSION

Give All Information Completely
Make Required Affidavit
Mail or Deliver Report to:
Conservation Division
State Corporation Commission
800 Bitting Building
Wichita, Kansas

WELL PLUGGING RECORD

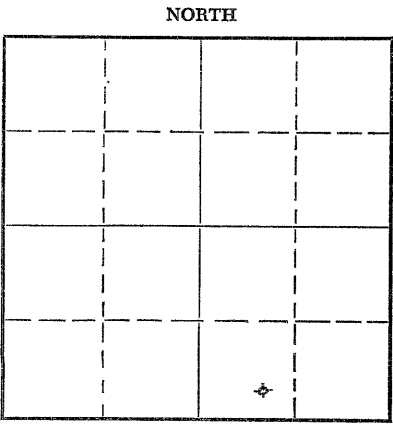

NORTH

Locate well correctly on above
Section Plat

Rooks _____ County. Sec. 4 Twp. 9S Rge. 18 (E) W (W)
Location as "NE/CNW/SW" or footage from lines SE/4 SW/4 SE/4
Lease Owner Birmingham-Bartlett Drilling Co. et al
Lease Name Yohe "A" Well No. 1
Office Address 300 Kaufman Building, Wichita 2, Kansas
Character of Well (completed as Oil, Gas or Dry Hole) Dry Hole
Date well completed October 10, 19 53
Application for plugging filed (Verbal) October 10, 19 53
Application for plugging approved (Verbal) October 10, 19 53
Plugging commenced October 10, 19 53
Plugging completed October 10, 19 53
Reason for abandonment of well or producing formation Dry Hole

If a producing well is abandoned, date of last production _____ 19____
Was permission obtained from the Conservation Division or its agents before plugging was commenced? Yes

Name of Conservation Agent who supervised plugging of this well Eldon Petty
Producing formation _____ Depth to top _____ Bottom _____ Total Depth of Well 3624 Feet
Show depth and thickness of all water, oil and gas formations.

OIL, GAS OR WATER RECORDS

CASING RECORD

FORMATION	CONTENT	FROM	TO	SIZE	PUT IN	PULLED OUT
		0	153'	8-5/8"	153'	none

Describe in detail the manner in which the well was plugged, indicating where the mud fluid was placed and the method or methods used in introducing it into the hole. If cement or other plugs were used, state the character of same and depth placed, from _____ feet to _____ feet for each plug set.

Bottom plug at 150'. 1/2 sack hulls and 15 sacks cement.
Top plug at 40'. 1/2 sack hulls and 10 sacks cement.

Received
10/13/53

(If additional description is necessary, use BACK of this sheet)
Name of Plugging Contractor Birmingham-Bartlett Drilling Co.
Address 300 Kaufman Building, Wichita 2, Kansas

STATE OF Kansas, COUNTY OF Sedgwick
Richard Hindery, partner of Birmingham-Bartlett Drilling Co., ^{ss.} owner and operator
(~~employee or agent~~) of the above-described well, being first duly sworn on oath, says: That I have knowledge of the facts, statements, and matters herein contained and the log of the above-described well as filed and that the same are true and correct. So help me God. BIRMINGHAM-BARTLETT DRILLING CO.
(Signature) By Richard Hindery Partner
300 Kaufman Building, Wichita 2, Kansas (Address)

SUBSCRIBED AND SWORN TO before me this 12th day of October, 19 53

My commission expires October 2, 1954
Beverly Larson
Notary Public.

24-7368-S 3-53-20M

PLUGGING
OCT 9 1953
135' LINE 16

WELL "A" NO. 1 WELL

LOCATION: SE/4 SW/4 SW/4
Section 4-38-18N
Rooks County, Kansas

STUDED: 9-28-53
COMPLETED: 10-10-53

OPERATOR and
CONTRACTOR: Birmingham-Bartlett Drilling Co.
900 Kaufman Building
Wichita 2, Kansas

SURFACE CASING: 8-5/8" casing cemented at 153'
with 125 sacks cement and 1 cu.

OIL STRING: None set. D & A.

LOG

(Figures indicate bottom of formation)

0 - 153	Shale
1000	Shale and shells
1100	Sand and shale
1140	Shale and shells
1395	Red Bed and shells
1435	Anhydrite
1935	Shale and shells
2000	Broken lime
2845	Lime and shale
2975	Shale and shells
3060	Lime and shale
3402	Lime
3505	Lime and shale
3624	Conglomerate
3624	Total Depth - D & A

The undersigned, Richard Hindery, one of the partners of Birmingham-Bartlett Drilling Co., hereby certifies that the above is a true and correct log of the formations encountered in drilling the Well "A" No. 1 Well as shown in the daily drilling reports.

BIRMINGHAM-BARTLETT DRILLING CO.

By Richard Hindery

Subscribed and sworn to before me this
12th day of October, 1953.

Beverly Larson

Notary Public

My commission expires October 2, 1955

