Conf. until

KANSAS CORPORATION COMMISSION
OIL & GAS CONSERVATION DIVISION

11-22-06

Form Must Be Typed

WELL COMPLETION FORM

WELL HISTORY - DESCRIPTION OF WELL & LEASE



Operator: License # 5214	API No. 15 - 095-20284-00-01
Name: Lario Oil & Gas Company	County: Kingman
Address: 301 S. Market Street	<u>ne_sw_nw_Sec24Twp27_SR. 5</u> East West
City/State/Zip: Wichita, KS 67207	3507 1650 feet from (S) (circle one) Line of Section
Purchaser: Plains Marketing / West Wichita Gas Gathering	4403 990 feet from (E) (W) (circle one) Line of Section
Operator Contact Person: Jay G. Schweikert	Footages Calculated from Nearest Outside Section Corner:
Phone: (316) 265-5611	(circle one) NE SE (NW) SW
Contractor: Name: Duke Drilling Company	Lease Name: Stannard Well #: 2-24 RE/SWD
License: 5292	Field Name: Bonjour
Wellsite Geologist: Doug V. Davis, Jr.	Producing Formation: Mississippian
Designate Type of Completion: (change construction)	Elevation: Ground: 1463 Kelly Bushing: 1471
New Well Re-Entry Workover	Total Depth: 4670 Plug Baçk Total Depth: 4670
Oil SWD SIOW Temp. Abd.	Amount of Surface Pipe Set and Gemented at 230 Feet
Gas ENHR SIGW	Multiple Stage Cementing Collar Used?
Dry Other (Core, WSW, Expl., Cathodic, etc)	If yes, show depth setFeet
If Workover/Re-entry: Old Well Info as follows:	If Alternate II completion, cement circulated from
Operator: J.A. Allison	feet depth tosx cmt.
Well Name: Bomholt #1	Drilling Fluid Management Plan
Original Comp. Date: 08/25/72 Original Total Depth: 4157'	Data must be collected from the Reserve Pit)
Deepening Re-perf Conv. to Enhr./SWD	Chloride content ppm Fluid volume bbls
Plug Back Total Depth	Dewatering method used
Commingled Docket No.	Location of fluid disposal if hauled offsite:
Dual Completion Docket No.	·
Other (SWD or Enhr.?) Docket No. D-28,403	Operator Name:
08/13/04 08/16/04 11/05/04	Lease Name: CLicense No.: Quarter Sec. Twp. S. R. East West
Spud Date or Date Reached TD Completion Date or Recompletion Date Completion Date	QuarterSecTwpS. R East West County:Shookel Nagge
	County: Docket No.
	KCC WICHITA
INSTRUCTIONS: An original and two copies of this form shall be filed with Kansas 67202, within 120 days of the spud date, recompletion, workove Information of side two of this form will be held confidential for a period of 107 for confidentiality in excess of 12 months). One copy of all wireline logs TICKETS MUST BE ATTACHED. Submit CP-4 form with all plugged wells.	r or conversion of a well. Rule 82-3-130, 82-3-106 and 82-3-107 apply. 2 months if requested in writing and submitted with the form (see rule 82-3- and geologist well report shall be attached with this form. ALL CEMENTING
All requirements of the statutes, rules and regulations promulgated to regular herein are complete and correct to the best of my knowledge.	te the oil and gas industry have been fully complied with and the statements
Signature: Jay Schwellest	KCC Office Use ONLY
Title: Operations/Engineer Date: January 30, 2006	Letter of Confidentiality Attached
Subscribed and sworn to before me this 30 th day of January	If Denied, Yes Date:
16 2006 . A KATHY I FORD	Wireline Log Received
Notary Public: KATHY L. FORD Notary Public - State of Kansas My Appt Expires 16-22-06	Geologist Report Received UIC Distribution
Date Commission Expires: 10-22-06	ı

Operator Name:	Lario (Oil & Gas Company	Lease N	Name: St	annard	**************************************	Well #: _2-2	24 RE/SWD	
Sec. 24 Twp. 2	27 s. R. 5	East West	County:	10.	ngman				
tested, time tool oper temperature, fluid rec	and closed, flowin overy, and flow rate	and base of formations pg and shut-in pressures if gas to surface test, final geological well site	, whether shu along with fin	ıt-in press	ure reached	static level, hydi	ostatic pressu	res, bottom hole	
Drill Stem Tests Taken (Attach Additional Sheets)		☐ Yes 🗾 No		✓ Log Formation (Top), Dep			and Datum	Sample	
Samples Sent to Geological Survey		Yes No		Name		Тор		Datum	
Cores Taken		Yes No		Indian Cave			1725	-254	
Electric Log Run (Submit Copy)		✓ Yes No		Lansin	g		2929		
List All E. Logs Run:			Stark Sh			le 3326 -1855			
GR CDL/CNL	DIL			Pawne	е		3521	-2050	
011 002/0112				Missis	sissippian		3720	-2249	
		CASING Report all strings set-	RECORD	✓ New face, interm	Used	ction, etc.			
Purpose of String	Size Hole Drilled	Size Casing Set (In O.D.)	Weigh	nt	Setting Depth	Type of Cement	# Sacks Used	Type and Percent Additives	
Surface (existed)		8-5/8"	LUS. 71		30	Cement	185	Additives	
Production	7-7/8"	5-1/2"	15.5	4	328	AA-2	200	5# Kolseal	
L		ADDITIONA	L CEMENTING	C / COURT	TE DECOR				
Purpose: Depth Top Bottom Perforate Protect Casing Plug Back TD Plug Off Zone		Type of Cement	#Sacks U		Type and Percent Additives				
Shots Per Foot PERFORATION RECORD - Bridge Plugs Specify Footage of Each Interval Perform						acture, Shot, Cement Squeeze Record mount and Kind of Material Used) Depth			
4	3733 - 43								
ОН	4328' - 4670'								
TUBING RECORD	Size See	Set At attached	Packer At diagram	L	iner Run	Yes 🗸 No)		
Date of First, Resumed I	Production, SWD or E	nhr. Producing Met	hod	Flowing	✓ Pumpi	ng Gas L	ift Oth	er (Explain)	
Estimated Production Per 24 Hours	Oil 0.5	Bbls. Gas	Mcf	Water		bls.	Gas-Oil Ratio	Gravity 33.0	
Disposition of Gas METHOD OF COMPLETION				73 40,000 33.0 Production Interval					
Vented Sold (If vented, Sur	Used on Lease	Open Hole Other (Spec	Perf.		ly Comp.	Commingled			

Stannard #2-24 RE/SWD

NE SW NW Sec. 24 - 27S - 05W Kingman Co., KS

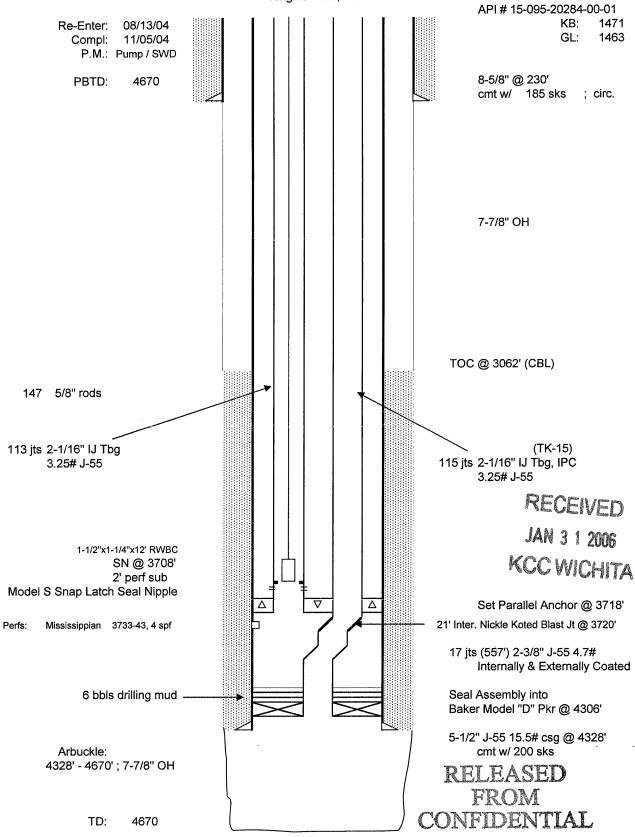

5/26/2005

Well stop flowing; Remove Dual Anchor & Install Rod Pumping Equipment

Prepared by: JGS Last Revision Date: 01/10/06

